

OCT 28 1994

LAND CORNER RECORDATION CERTIFICATE
Filing Requirement of Act 74, Mich. P.A. 1970

STATE OF MICHIGAN
 COUNTY OF KENT
 RECEIVED FOR RECORD

94 AUG 24 AM 11:52

For corners in

COMMISSION

Kent

(County)

Located In:

Cannon Twp.
 Corner Code #


- | | | |
|------------------------------------|--------------------------|----------------------|
| 1. Public Land Survey | T <u>8N</u> R <u>10W</u> | <u>F-2</u> |
| | T _____ R _____ | <u>Center Sec. 4</u> |
| | T _____ R _____ | _____ |
| | T _____ R _____ | _____ |
| 2. Property Controlling in Section | S _____ T _____ R _____ | _____ |
| | S _____ T _____ R _____ | _____ |
| 3. Miscellaneous Property in Sec. | S _____ T _____ R _____ | _____ |
| | S _____ T _____ R _____ | _____ |

Leif J. Bond
 REG. OF DEEDS

6979

Register of Deeds Stamp & File Number

4. Lot No. _____, Recorded Plat _____
5. Private Claims _____

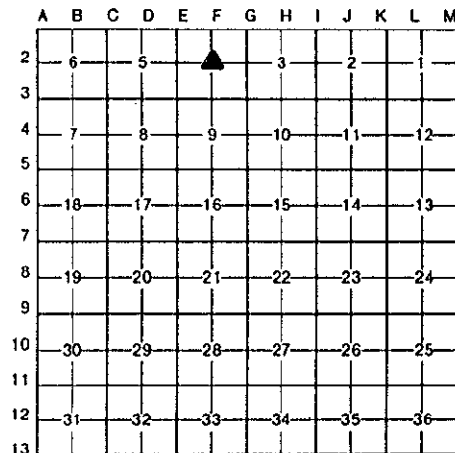

I, Wallace E. Glaza in a field survey on August 4, 19 94, do hereby certify that under requirements of P.A. 74, Michigan P.A. of 1970, the corner points mentioned in lines 1 and 2 above were in conformance with regulations and rules therefore as required in the current manual of survey instructions of the United States Department of the Interior, Bureau of Land Management or by a decree of a Court of Law and/or that the corner points mentioned in lines 3, 4 and 5 above were in conformance with the rules of the Michigan Board of Land Surveyors or by a Decree of a Court of Law; established, re-established, monumented, re-monumented, recovered, found as expressed below:

NOTE: Not more than 4 corners, all in the same town and range, may be recorded on this certificate.

A. Description of original monument and accessories and/or subsequent restoration:

L.C.R.C. No. 495

- | | |
|------------------------------------|---------------------------|
| Iron | "T" iron set by witnesses |
| C.P. Pole NE 48.15' | C.P. Pole N40°E 82.10' |
| 3.3' N. of E-W fence | C.P. Pole N70°E 48.72' |
| Centerline E-W power line N. 18.5' | C.P. Pole S20°E 14.62' |
| | Iron East 56.0' |

B. Description of corner evidence found and/or method applied in restoring or reestablishing corner:

F-2 (Center of Section 4, T8N, R10W, Cannon Township, Kent County, Michigan)

Found ½" iron pipe in monument box. Verified ½" iron pipe to be at the intersection of the ¼ lines.
 Replaced ½" Iron pipe with standard 4" x 30" Kent County monument. (Harrison)

- West ¼ corner to Center - 2643.00'
 North ¼ corner to Center - 3477.05'
 East ¼ corner to Center - 2644.33'
 South ¼ corner to Center - 2657.20'

P.A. 345 1990 KENT COUNTY


PEER APPROVED 7/28/94

CHAIRMAN *Harry Huber*

C. Description of monument for corner and accessories established to perpetuate locating the position of the corner:

F-2 (4" x 30" Kent County monument)

- | | |
|---|---------------|
| 1) Remon tag & nail in NW'ly side P. Pole | N69°E 48.73' |
| 2) Remon tag & nail in NW'ly side P. Pole | N30°E 96.69' |
| 3) Remon tag & nail in W'ly side P. Pole | S24°E 147.94' |
| 4) Remon tag & nail in E'ly side "Circle 33 Ranch" sign | S43°W 70.36' |
| 5) Remon tag & nail in SE'ly side 20" tree | S86°W 103.82' |
| 6) 18' South of E-W overhead power lines | |

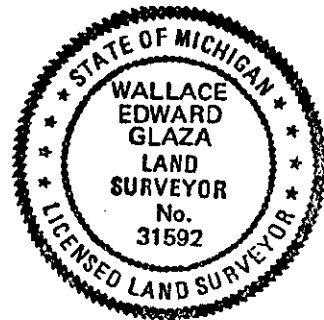

Signed by Wallace E. Glaza
 Glaza and Associates, Inc.
 Surveyor's Michigan License No. 31592

Date August 5, 1994