

SURVEY & REMONUMENTATION

MAR 03 1998

SECTION

**LAND CORNER RECORDATION CERTIFICATE
Filing Requirement of Act 74, Mich. P.A. 1970
KENT COUNTY REMONUMENTATION**

For corners in

Kent (County)	Located in: Cannon Township	Corner Code #
1. Public Land Survey	T <u>8N</u> R <u>10W</u>	<u>F-3</u>
	T _____ R _____	_____
	T _____ R _____	_____
	T _____ R _____	_____
2. Property Controlling in Section	S _____ T _____ R _____	_____
	S _____ T _____ R _____	_____
3. Miscellaneous Property in Sec.	S _____ T _____ R _____	_____
	S _____ T _____ R _____	_____


STATE OF MICHIGAN
 COUNTY OF KENT
 RECEIVED FOR RECORD
 97 OCT 15 AM 8:45
 REG. OF DEEDS
Lucy Bond

10109

Register of Deeds Stamp & File Number

- 4. Lot No. _____, Recorded Plat _____
- 5. Private Claims _____

I, Randy Kolehouse, in a field survey on June 12 19 97, do hereby certify that under requirements of P.A. 74 Michigan P.A. of 1970, the corner points mentioned in lines 1 and 2 above were in conformance with regulations and rules therefore as required in the current manual of survey instructions of the United States Department of the interior, Bureau of Land Management or by a decree of a Court of Law and/or that the corner points mentioned in lines 3, 4 and 5 above were in conformance with the rules of the Michigan Board of Land Surveyors or by a Decree of a Court of Law; established, re-established, monumented, re-monumented, recovered, found as expressed below:

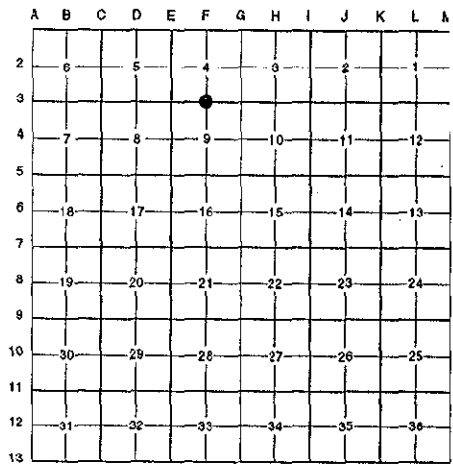

NOTE: Not more than 4 corners, all in the same town and range, may be recorded on this certificate.

A. Description of original monument and accessories and/or subsequent restoration:

F-3	1831	G.L.O. Notes	Mullett	Set Post
	N/A	Witness Map	K.C. Surveyor	1" Iron
	1973	L.C.R.C. #495	Williams & Works	1" Iron in Mon. Box
	1977	L.C.R.C. #1048	Williams & Works	5/8" Iron in Mon. Box
	1981	L.C.R.C. #2432	Jonker Land Surveys	Fnd. 5/8" Iron in Mon. Box / Set K.C. Monument in Mon. Box
	1991	L.C.R.C. #6303	Chris Marschall	K.C. Monument

This corner was originally approved by the Kent County Remonumentation Peer Group and monumented by Rob Jonker on 11/30/81 and was recorded per L.C.R.C. #2432.

B. Description of corner evidence found and/or method applied in restoring or reestablishing corner:

F-3 Found a Standard Kent County Monument in a monument box at the C/L intersection of Myers Lake Avenue (bit.) running North and South and 9 Mile Road (bit.) running East and West per L.C.R.C.'s #2432 and #6303 as set by Rob Jonker in place of a 5/8" iron he found in a monument box which checked L.C.R.C.'s #1048, #495 and the K.C. Surveyor's records.

L.C.R.C. #2432

L.C.R.C. #6303

SW corner conc. bldg. N41°E 125.23'
On C/L "X" pavement


Nail & Tag S sd. 18" Oak N 85 W 185.19' (m. 185.23')
SW cor. bldg. #7620 N 41 E 125.14' (m. 125.22')
Nail & Tag N sd. U.P. S 80 E 117.44'
On C/L "X" pavement

The selected location is accepted by me and is generally accepted by professional surveyors as the best available evidence of the position of the original corner.

C. Description of monument for corner and accessories established to perpetuate locating the position of the corner:

F-3 Standard Kent County Monument in a Monument Box
 Nail & K.C. remon. tag on S side 18" Oak N 85° W 185.23'
 SW cor. bldg. #7620 N 41° E 125.22'
 Nail & K.C. remon. tag on N side Util. pole S 80° E 117.44'
 Top C/L fence post S 50° E 83.27'

P.A. 345 1990 KENT COUNTY
 PEER APPROVED 6/26/97
 CHAIRMAN *Harvey Huber*

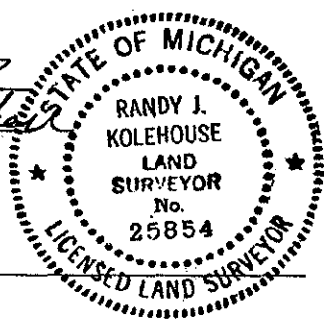

Signed by *Randy J. Kolehouse*
 EARTH TECH

Date 8/12/97

Surveyor's Michigan License No. 25854