

**SURVEY & REMONUMENTATION**  
 \$7.00  
 \$2.00 MAR 03 1998

**SECTION**

**LAND CORNER RECORDATION CERTIFICATE**  
 Filing Requirement of Act 74, Mich. P.A. 1970  
 KENT COUNTY REMONUMENTATION

STATE OF MICHIGAN  
 COUNTY OF KENT  
 RECEIVED FOR RECORD  
 97 DEC 15 AM 10:44  
 REG. OF DEEDS  
*Lucy Bond*

For corners in Kent (County)

Located in: Cannon Township Corner Code #


1. Public Land Survey	T <u>8N</u>	R <u>10W</u>	<u>F-4</u>
	T _____	R _____	_____
	T _____	R _____	_____
	T _____	R _____	_____
2. Property Controlling in Section	S _____	T _____	R _____
	S _____	T _____	R _____
3. Miscellaneous Property in Sec.	S _____	T _____	R _____
	S _____	T _____	R _____

4. Lot No. \_\_\_\_\_, Recorded Plat \_\_\_\_\_

5. Private Claims \_\_\_\_\_

**10398**  
 Register of Deeds Stamp & File Number

I, Randy Kolehouse, in a field survey on June 12 19 97, do hereby certify that under requirements of P.A. 74 Michigan P.A. of 1970, the corner points mentioned in lines 1 and 2 above were in conformance with regulations and rules therefore as required in the current manual of survey instructions of the United States Department of the interior, Bureau of Land Management or by a decree of a Court of Law and/or that the corner points mentioned in lines 3, 4 and 5 above were in conformance with the rules of the Michigan Board of Land Surveyors or by a Decree of a Court of Law; established, re-established, monumented, re-monumented, recovered, found as expressed below:

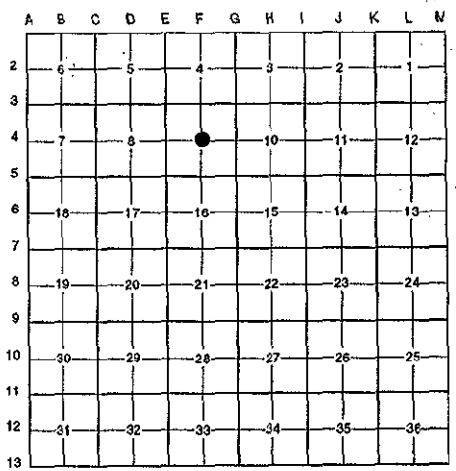

**NOTE:** Not more than 4 corners, all in the same town and range, may be recorded on this certificate.

A. Description of original monument and accessories and/or subsequent restoration:

F-4 This corner was not originally set by the G.L.O.

1940	Witness Map	K.C. Surveyor	1" Iron
1973	L.C.R.C. #610	Medema, Van Kooten & Assoc.	Iron in Monument Box
1977	L.C.R.C. #1048	Williams & Works	5/8" Iron in Monument Box

P.A. 345 1990 KENT COUNTY  
 PEER APPROVED 11/20/97  
 CHAIRMAN *Hamp Huber*

B. Description of corner evidence found and/or method applied in restoring or reestablishing corner:

F-4 Found a 1' iron in a monument box on the C/L of Myers Lake Avenue (bit.) running North and South and 2' North of the C/L of Silver Lake Road (bit.) running East on line of a fence line running West per L.C.R.C.'s #1048, #610 and the K.C. Surveyor's records. Iron is at the intersection of 1/4 lines. Accepted iron as Center of Section.


L.C.R.C. #610	L.C.R.C. #1048
Nail in 6" Wild Cherry West 49.30'	8" West Cherry West 49.35'
	Top centerline of fence post N 75° E 95.93'

The selected location is accepted by me and is generally accepted by professional surveyors as the best available evidence of the position of the original corner.

C. Description of monument for corner and accessories established to perpetuate locating the position of the corner:

F-4 Replaced 1" Iron with a Standard Kent County Monument in a Monument Box

- Nail & K.C. remon. tag on E side 10" Willow N 40° W 49.46'
- Nail & K.C. remon. tag on S side 8" Poplar N 48° E 66.43'
- Nail & K.C. remon. tag on SW side P. pole S 45° E 62.00'
- Nail & K.C. remon. tag on S side 6" Chessnut N 83° W 40.84'
- 8" Cherry West 49.35'

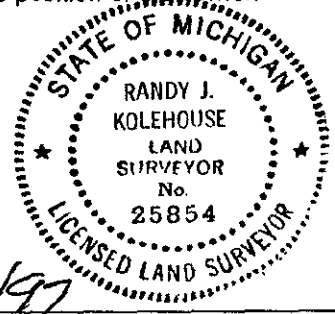

Signed by *Randy J. Kolehouse* Date 11/24/97  
 EARTH TECH  
 Surveyor's Michigan License No. 25854