

SURVEY & REMONUMENTATION

MAR 03 1998

LAND CORNER RECORDATION CERTIFICATE
Filing Requirement of Act 74, Mich. P.A. 1970
KENT COUNTY REMONUMENTATION

SECTION
 For corners in

<u>Kent</u> (County)	Located in: Cannon Township	Corner Code #
1. Public Land Survey	T <u>8N</u> R <u>10W</u>	<u>E-7</u>
	T _____ R _____	_____
	T _____ R _____	_____
	T _____ R _____	_____
2. Property Controlling in Section	S _____ T _____ R _____	_____
	S _____ T _____ R _____	_____
3. Miscellaneous Property in Sec.	S _____ T _____ R _____	_____
	S _____ T _____ R _____	_____

STATE OF MICHIGAN
 COUNTY OF KENT
 REGISTERED FOR RECORD

97 OCT 15 AM 8:45

REG. OF DEEDS


Handwritten Signature

10111

Register of Deeds Stamp & File Number

4. Lot No. _____, Recorded Plat _____
 5. Private Claims _____

I, Randy Kolehouse, in a field survey on June 12 19 97, do hereby certify that under requirements of P.A. 74 Michigan P.A. of 1970, the corner points mentioned in lines 1 and 2 above were in conformance with regulations and rules therefore as required in the current manual of survey instructions of the United States Department of the interior, Bureau of Land Management or by a decree of a Court of Law and/or that the corner points mentioned in lines 3, 4 and 5 above were in conformance with the rules of the Michigan Board of Land Surveyors or by a Decree of a Court of Law; established, re-established, monumented, re-monumented, recovered, found as expressed below:

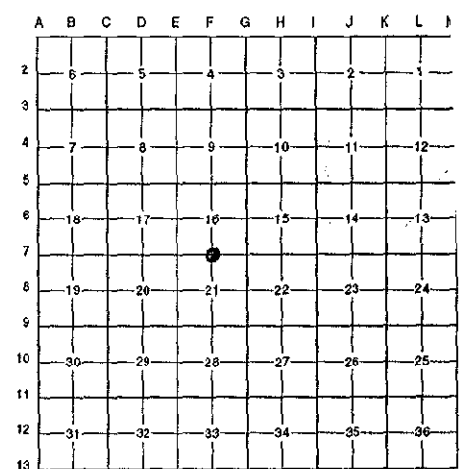

NOTE: Not more than 4 corners, all in the same town and range, may be recorded on this certificate.

A. Description of original monument and accessories and/or subsequent restoration:

F-7	1831	G.L.O. Notes	Mullett	Set Post
	N/A	Witness Map	K.C. Surveyor	Iron
	1979	L.C.R.C. #1268	Exxel Engineering	1/2" Iron
	1981	L.C.R.C. #2430	Jonker Land Surveys	Fnd. 1/2" Iron / Set K.C. Monument
	1992	L.C.R.C. #6305	Chris Marschall	K.C. Monument

P.A. 345 1990 KENT COUNTY
 PEER APPROVED 6/26/97
 CHAIRMAN Randy Kolehouse

This corner was originally approved by the Kent County Remonumentation Peer Group and monumented by Rob Jonker on 12/5/81 and was recorded per L.C.R.C. #2430.

B. Description of corner evidence found and/or method applied in restoring or reestablishing corner:
 F-7 Found a Standard Kent County Monument on the C/L of Myers Lake Avenue (bit.) running North and South per L.C.R.C.'s #2430 and #6305 as set by Rob Jonker in place of a 1/2" iron he found which checked L.C.R.C. #1268 and the K.C. Surveyor's records.

L.C.R.C. #2430

- Remon. tag on top guard post S24°W 50.42'
- Remon. tag on NE side 16" Oak S30°E 79.61'
- Remon. tag on S side 30" Maple S87°E 46.2'
- Remon. tag on SW side tw. 14" Maple N19°W 74.8'

L.C.R.C. #6305


- Nail & Tag Top 6"x8" Guard Rail Post S 20 W 50.41'
- Nail & Tag SW sd. 20" Oak (3' above grd.) S 34 E 79.93'
- Nail & Tag NW sd. 16" Elm (4' above grd.) W 59 E 30.82'
- Nail & Tag S sd. 38" Maple (7' above grd.) S 90 E 46.22'
- On C/L Bit. N-S

The selected location is accepted by me and is generally accepted by professional surveyors as the best available evidence of the position of the original corner.

C. Description of monument for corner and accessories established to perpetuate locating the position of the corner:

F-7 Standard Kent County Monument

- Nail & K.C. remon. tag on top of 6" x 8" guard rail post S 20° W 50.41'
- Nail & K.C. remon. tag on SW side 20" Oak S 34° E 79.93'
- Nail & K.C. remon. tag on NW side 16" Elm (4' above gnd.) N 59° E 30.82'
- Nail & K.C. remon. tag on S side 40" Maple (7' above gnd.) S 90° E 46.22'

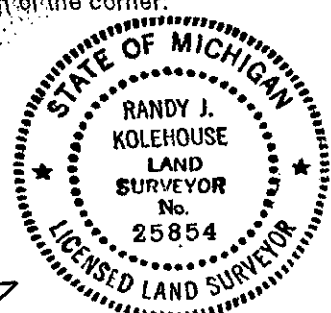

Signed by Randy J. Kolehouse
 EARTH TECH

Date 8/12/97

Surveyor's Michigan License No. 25854