

**SURVEY & REMONUMENTATION**

MAR 03 1998

**SECTION**

**LAND CORNER RECORDATION CERTIFICATE**  
**Filing Requirement of Act 74, Mich. P.A. 1970**  
**KENT COUNTY REMONUMENTATION**

For corners in

Kent (County)	Located in: Cannon Township	Corner Code #
1. Public Land Survey	T <u>8N</u> R <u>10W</u>	<u>F-13</u>
	T _____ R _____	_____
	T _____ R _____	_____
	T _____ R _____	_____
2. Property Controlling in Section	S _____ T _____ R _____	_____
	S _____ T _____ R _____	_____
3. Miscellaneous Property in Sec.	S _____ T _____ R _____	_____
	S _____ T _____ R _____	_____

STATE OF MICHIGAN  
 COUNTY OF KENT  
 RECEIVED FOR RECORD  
 97 OCT 15 AM 8:45  
 REG. OF DEEDS  
*David Stand*

**10114**

Register of Deeds Stamp & File Number

4. Lot No. \_\_\_\_\_, Recorded Plat \_\_\_\_\_  
 5. Private Claims \_\_\_\_\_

I, Randy Kolehouse, in a field survey on June 12 19 97, do hereby certify that under requirements of P.A. 74 Michigan P.A. of 1970, the corner points mentioned in lines 1 and 2 above were in conformance with regulations and rules therefore as required in the current manual of survey instructions of the United States Department of the interior, Bureau of Land Management or by a decree of a Court of Law and/or that the corner points mentioned in lines 3, 4 and 5 above were in conformance with the rules of the Michigan Board of Land Surveyors or by a Decree of a Court of Law; established, re-established, monumented, re-monumented, recovered, found as expressed below:

	A	B	C	D	E	F	G	H	I	J	K	L	M
2	6		5		4		3		2		1		
3													
4	7		8		9		10		11		12		
5													
6	18		17		16		15		14		13		
7													
8	19		20		21		22		23		24		
9													
10	30		29		28		27		26		25		
11													
12	31		32		33		34		35		36		
13													

**NOTE: Not more than 4 corners, all in the same town and range, may be recorded on this certificate.**

**A. Description of original monument and accessories and/or subsequent restoration:**

F-13	1831	G.L.O. Notes	Mullett	Set Post
	1893	Notes	Williams & Works	N/A
	1964	Witness Map	K.C. Surveyor	Iron
	1984	L.C.R.C. #3960	Exxel Engineering	Fnd. "T" Iron / Set K.C. Monument
	1992	L.C.R.C. #6308	Chris Marschall	K.C. Monument

P.A. 345 1990 KENT COUNTY  
 PEER APPROVED 6/26/97  
 CHAIRMAN Randy Kolehouse

Note: This corner is not common with F-1, T7N, R10W.

This corner was originally approved by the Kent County Remonumentation Peer Group and monumented by Exxel Engineering on 9/7/84 and was recorded per L.C.R.C. #3960.

**B. Description of corner evidence found and/or method applied in restoring or reestablishing corner:**

F-13 Found a Standard Kent County Monument on the North edge of 4 Mile Road (gravel) running East and West per L.C.R.C.'s #3960 and #6308 as set by Exxel Engineering in place of a "T" iron they found which checks the 1893 notes of Williams & Works and the K.C. Surveyor's records.

L.C.R.C. #3960

L.C.R.C. #6308

Nail & Remon tag in S sde 36" Oak N67°W 82.58'  
 NE cor brick chimney (on E sde hse) N14°W 89.15'  
 Nail & remon tag in E sde 8" Walnut S24°W 118.95'  
 C.I. monument N 1/4 corner, Section 4, T7N, R10W West 270.93'


NE corner brick chimney (on East sd of hse) N 17° W 89.08'  
 Nail & tag S sd. 40" Oak N 72° W 82.59'  
 Nail & Tag E sd. 10" Walnut S 20° W 118.91'  
 Nail & Tag SW sd. P.P. S 45° E 57.58'  
 Nail & Tag S sd. Quad 12" Oak S 75° W 79.46'  
 Mon 7N 10W F-1 N 90° W 270.87'

The selected location is accepted by me and is generally accepted by professional surveyors as the best available evidence of the position of the original corner.

**C. Description of monument for corner and accessories established to perpetuate locating the position of the corner:**

F-13 Standard Kent County Monument

NE cor. brick chimney (on E side of hse) N 17° W 89.08'  
 Nail & K.C. remon. tag on S side 40" Oak N 72° W 82.59'  
 Nail & K.C. remon. tag on E side 10" Walnut S 20° W 118.91'  
 Nail & K.C. remon. tag on SW side P. pole S 45° E 57.58'  
 Nail & K.C. remon. tag on S side quad. 12" Oak S 75° W 79.46'  
 K.C. Mon., F-1, T7N, R10W, West 270.87'

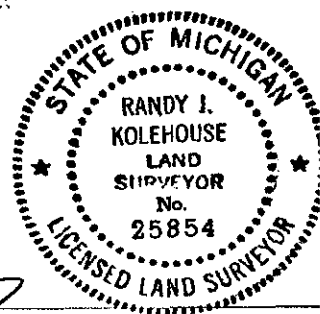

Signed by Randy J. Kolehouse Date 8/12/97  
 EARTH TECH

Surveyor's Michigan License No. 25854