

**SURVEY & REMONUMENTATION**

MAR 03 1998

**LAND CORNER RECORDATION CERTIFICATE**  
**Filing Requirement of Act 74, Mich. P.A. 1970**  
 KENT COUNTY REMONUMENTATION

**SECTION**

For corners in

Kent  
 (County)

Located in: Cannon Township

Corner Code #

1. Public Land Survey	T <u>8N</u> R <u>10W</u>	<u>G-3</u>
	T _____ R _____	_____
	T _____ R _____	_____
	T _____ R _____	_____
2. Property Controlling in Section	S _____ T _____ R _____	_____
	S _____ T _____ R _____	_____
3. Miscellaneous Property in Sec.	S _____ T _____ R _____	_____
	S _____ T _____ R _____	_____


STATE OF MICHIGAN  
 COUNTY OF KENT  
 RECEIVED FOR RECORD  
 97 OCT 15 AM 8:45  
 REG. OF DEEDS  
*Eric J. Bond*

**10116**

Register of Deeds Stamp & File Number

4. Lot No. \_\_\_\_\_, Recorded Plat \_\_\_\_\_  
 5. Private Claims \_\_\_\_\_

I, Randy Kolehouse, in a field survey on June 24 19 97, do hereby certify that under requirements of P.A. 74 Michigan P.A. of 1970, the corner points mentioned in lines 1 and 2 above were in conformance with regulations and rules therefore as required in the current manual of survey instructions of the United States Department of the interior, Bureau of Land Management or by a decree of a Court of Law and/or that the corner points mentioned in lines 3, 4 and 5 above were in conformance with the rules of the Michigan Board of Land Surveyors or by a Decree of a Court of Law; established, re-established, monumented, re-monumented, recovered, found as expressed below:

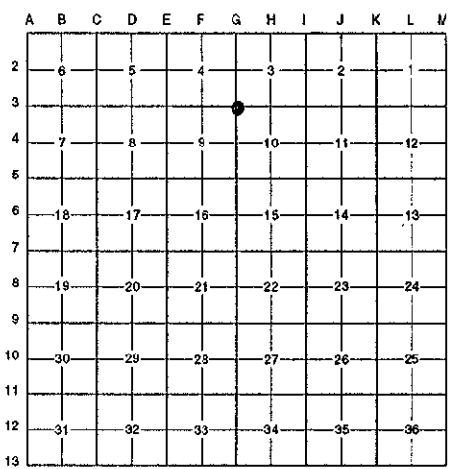

**NOTE: Not more than 4 corners, all in the same town and range, may be recorded on this certificate.**

**A. Description of original monument and accessories and/or subsequent restoration:**

G-3	1831	G.L.O. Notes	Mullett	Set Post
	1934	Witness Map	K.C. Surveyor	1" Iron
	1972	L.C.R.C. #331	Williams & Works	1/2" Iron
	1981	L.C.R.C. #2428	Jonker Land Survey	Fnd. 1/2" Iron / K.C. Monument
	1992	L.C.R.C. #6310	Chris Marschall	K.C. Monument in a Monument Box

This corner was originally approved by the Kent County Remonumentation Peer Group and monumented by Rob Jonker on 11/30/81 and was recorded per L.C.R.C. #2428.

**B. Description of corner evidence found and/or method applied in restoring or reestablishing corner:**

G-3 Found a Standard Kent County Monument 1' South of the C/L of 9 Mile Road (bit.) running East and West and 25' ± East of the C/L of Wilkinson Road (bit.) running South per L.C.R.C.'s #2428 and #6310 as set by Rob Jonker in place of a 1/2" iron he found at grade over a 3/4" iron 14" below grade which checked L.C.R.C. #331 and the K.C. Surveyor's records.

L.C.R.C. #2428

L.C.R.C. #6310

Remon. tag on NE side t. pole N 62° W 59.08'	Nail & Tag SW sd. U.P. N 50 W 59.66'
Remon. tag on NW side t. pole S 62° W 62.10'	Nail & Tag NE sd. 12" Twin Sass. (stump) N 45 W 39.74'
Remon. tag on W side 15" Sassafras S 03° W 77.28'	Nail & Tag N sd. U.P. S 45° W 62.05'
Remon. tag on E side 8" tw. Sassafras N 05° W 35.67' (stump)	Nail & Tag W sd. 18" Twin Sass. S 03 W 77.25'


The selected location is accepted by me and is generally accepted by professional surveyors as the best available evidence of the position of the original corner.

**C. Description of monument for corner and accessories established to perpetuate locating the position of the corner:**

G-3 Standard Kent County Monument

- Nail & K.C. remon. tag on SW side Util. pole N 50° W 59.66'
- Nail & K.C. remon. tag on NE side 12" Twin Sassafras (stump) N 45° W 39.74'
- Nail & K.C. remon. tag on N side Util. pole S 45° W 62.05'
- Nail & K.C. remon. tag on W side 20" Sassafras S 03° W 77.25'

P.A. 345 1990 KENT COUNTY  
 PEER APPROVED 6/26/97  
 CHAIRMAN [Signature]

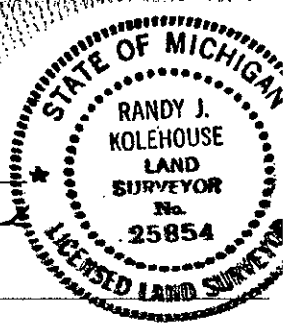

Signed by Randy J. Kolehouse  
 EARTH TECH

Date 6/12/97

Surveyor's Michigan License No. 25854