

**SURVEY & REMONUMENTATION**

MAR 03 1998

**LAND CORNER RECORDATION CERTIFICATE**  
**Filing Requirement of Act 74, Mich. P.A. 1970**  
**KENT COUNTY REMONUMENTATION**

**SECTION**

For corners in

Kent (County)	Located in: Cannon Township	Corner Code #
1. Public Land Survey	T <u>8N</u> R <u>10W</u>	<u>G-13</u>
	T _____ R _____	_____
	T _____ R _____	_____
	T _____ R _____	_____
2. Property Controlling in Section	S _____ T _____ R _____	_____
	S _____ T _____ R _____	_____
3. Miscellaneous Property in Sec.	S _____ T _____ R _____	_____
	S _____ T _____ R _____	_____

REG. OF DEEDS  
*Eric J. Bond*

STATE OF MICHIGAN  
 COUNTY OF KENT  
 RECEIVED FOR RECORD  
 97 OCT 15 AM 8:45

10120

Register of Deeds Stamp & File Number


4. Lot No. \_\_\_\_\_, Recorded Plat \_\_\_\_\_  
 5. Private Claims \_\_\_\_\_

I, Randy Kolehouse, in a field survey on June 13 19 97, do hereby certify that under requirements of P.A. 74 Michigan P.A. of 1970, the corner points mentioned in lines 1 and 2 above were in conformance with regulations and rules therefore as required in the current manual of survey instructions of the United States Department of the interior, Bureau of Land Management or by a decree of a Court of Law and/or that the corner points mentioned in lines 3, 4 and 5 above were in conformance with the rules of the Michigan Board of Land Surveyors or by a Decree of a Court of Law; established, re-established, monumented, re-monumented, recovered, found as expressed below:

**NOTE: Not more than 4 corners, all in the same town and range, may be recorded on this certificate.**

A. Description of original monument and accessories and/or subsequent restoration:

G-13	1831	G.L.O. Notes	Mullett	Set Post
	1964	Witness Map	K.C. Surveyor	Iron
	1978	L.C.R.C. #1222	William Byl	2" Iron Pipe
	1981	L.C.R.C. #1779	Williams & Works	Fnd. Re-rod w/Cap in 2" Iron Pipe / Set K.C. Monument
	1991	L.C.R.C. #6319	Chris Marschall	K.C. Monument

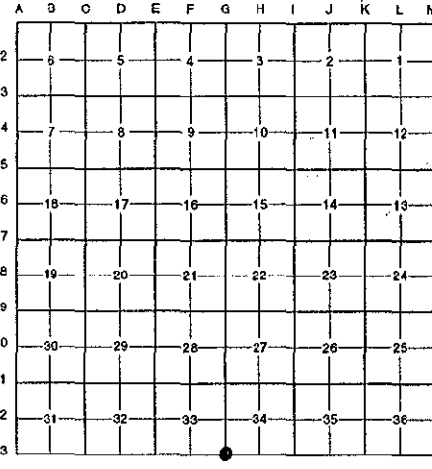

Note: This corner is not common with G-1, T7N, R10W.

P.A. 345 1990 KENT COUNTY  
 PEER APPROVED 6/26/97  
 CHAIRMAN Harry Kube

This corner was originally approved by the Kent County Remonumentation Peer Group and monumented by Williams & Works on 1/28/81 and was recorded per L.C.R.C. #1779.

B. Description of corner evidence found and/or method applied in restoring or reestablishing corner:

G-13 Found a Standard Kent County Monument 4' South of the C/L of 4 Mile Road (gravel) running East and West and 15' ± East of the C/L of Dursum Avenue (gravel) running North per L.C.R.C.'s #1779 and #6319 as set by Williams & Works in place of a re-rod w/cap they found in a 2" iron pipe which checked L.C.R.C. #1222 and the K.C. Surveyor's records.

L.C.R.C. #1779

L.C.R.C. #6319


K.C. Remon. Tag & Nail in S Side 30" Oak N 70° E 100.87'	Nail & Tag S sd. 32" Oak N 70 E 100.69'
K.C. Remon. Tag & Nail in N Side 16" Oak S 60° E 93.05'	Nail & Tag N sd. 18" Oak (6' above ground) S 60 E 92.55'
K.C. Remon. Tag & Nail in NW Side 16" Twin Oak S 50° W 46.52'	Nail & Tag NW sd. 18" win Oak S 50 W 46.40'
K.C. Remon. Tag & Nail in E Side 12" Twin Oak N 50° W 87.23'	Nail & Tag E sd. 14" Twin Oak N 50 W 87.04'

The selected location is accepted by me and is generally accepted by professional surveyors as the best available evidence of the position of the original corner.

C. Description of monument for corner and accessories established to perpetuate locating the position of the corner:

G-13 Standard Kent County Monument

- Nail & K.C. remon. tag on S side 32" Oak N 70° E 100.69'
- Nail & K.C. remon. tag on N side 18" Oak (6' above gnd.) N 60° E 92.55'
- Nail & K.C. remon. tag on NW side 18" Twin Oak S 50° W 46.40'
- Nail & K.C. remon. tag on E side 14" Twin Oak N 50° W 87.04'
- K.C. Mon., G-1, T7N, R10W, West 277.27'

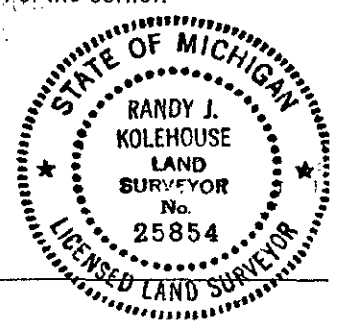

Signed by Randy J. Kolehouse  
 EARTH TECH

Date 8/12/97

Surveyor's Michigan License No. 25854