

SURVEY & REMONUMENTATION

MAR 03 1998

SECTION

LAND CORNER RECORDATION CERTIFICATE
Filing Requirement of Act 74, Mich. P.A. 1970
KENT COUNTY REMONUMENTATION

For corners in

Kent (County)	Located in: Cannon Township	Corner Code #
1. Public Land Survey	T <u>8N</u> R <u>10W</u>	<u>H-1</u>
	T _____ R _____	_____
	T _____ R _____	_____
	T _____ R _____	_____
2. Property Controlling in Section	S _____ T _____ R _____	_____
	S _____ T _____ R _____	_____
3. Miscellaneous Property in Sec.	S _____ T _____ R _____	_____
	S _____ T _____ R _____	_____

REG. OF DEEDS

Lucy Bond

97 OCT 15 AM 8:45


STATE OF MICHIGAN
 COUNTY OF KENT
 RECEIVED FOR RECORD

10121

Register of Deeds Stamp & File Number

4. Lot No. _____, Recorded Plat _____
 5. Private Claims _____

I, Randy Kolehouse, in a field survey on June 24 19 97, do hereby certify that under requirements of P.A. 74 Michigan P.A. of 1970, the corner points mentioned in lines 1 and 2 above were in conformance with regulations and rules therefore as required in the current manual of survey instructions of the United States Department of the interior, Bureau of Land Management or by a decree of a Court of Law and/or that the corner points mentioned in lines 3, 4 and 5 above were in conformance with the rules of the Michigan Board of Land Surveyors or by a Decree of a Court of Law; established, re-established, monumented, re-monumented, recovered, found as expressed below:

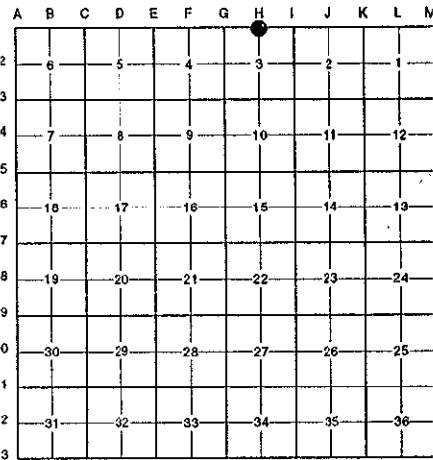

NOTE: Not more than 4 corners, all in the same town and range, may be recorded on this certificate.

A. Description of original monument and accessories and/or subsequent restoration:

H-1	This corner was not originally set by the G.L.O.
1939-80	Notes Williams & Works Iron
1944	Witness Map K.C. Surveyor 1" Iron
1972	L.C.R.C. #331 Williams & Works "T" Iron
1984	L.C.R.C. #3981 William Byl Fnd. 1" Iron Pipe in Mon. Box / Set K.C. Monument in Mon. Box
1992	L.C.R.C. #6211 Chris Marschall K.C. Monument in Monument Box

P.A. 345 1990 KENT COUNTY
 PEER APPROVED 6/26/97
 CHAIRMAN Randy Kolehouse

Note: This corner is not common with H-13, T9N, R10W.

This corner was originally approved by the Kent County Remonumentation Peer Group and monumented by William Byl on 10/16/84 and was recorded per L.C.R.C. #3981.

B. Description of corner evidence found and/or method applied in restoring or reestablishing corner:

H-1 Found a Standard Kent County Monument on the Township line at the C/L of 10 Mile Road (bit.) running East and West per L.C.R.C.'s #3981 and #6211 as set by William Byl in place of a 1" iron pipe he found in a monument box 122.12' East of South 1/4 corner of Section 34 and 0.12' North of the South line of Section 34. Checked L.C.R.C. #331 and the K.C. Surveyor's records.

L.C.R.C. #3981

- Nail & tag, E sd. power pole S 30 W 33.66'
- Nail & tag, W sd. 48" Oak S 00 W 50.54'
- Nail & tag, W sd. 24" Oak N 40 W 35.13'
- Nail & tag, W sd. 15" Maple S 25 E 46.31'


L.C.R.C. #6211

- Nail & Tag W sd. 50" Oak S 03 E 50.45'
- Nail & Tag E sd. U.P. S 29 W 33.63'
- Nail & Tag W sd. 18" Maple S 29 E 46.30'
- Nail & Tag NE sd. 26" Oak N 40 W 35.11'
- Mon. H-13 9N 10W N 90 W 122.13'

The selected location is accepted by me and is generally accepted by professional surveyors as the best available evidence of the position of the original corner.

C. Description of monument for corner and accessories established to perpetuate locating the position of the corner:

- H-1 Standard Kent County Monument
- Nail & K.C. remon. tag on W side 50" Oak S 03° E 50.45'
 - Nail & K.C. remon. tag on E side U. pole S 29° W 33.63'
 - Nail & K.C. remon. tag on W side 18" Maple S 29° E 46.30'
 - Nail & K.C. remon. tag on NE side 26" Oak N 40° W 35.11'
 - K.C. Mon., H-13, T9N, R10W, West 122.13'

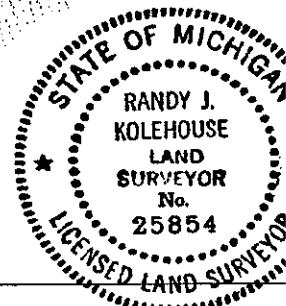

Signed by Randy J. Kolehouse Date 8/12/97

Surveyor's Michigan License No. 25854