

SURVEY & REMONUMENTATION

MAR 03 1998

SECTION

LAND CORNER RECORDATION CERTIFICATE
Filing Requirement of Act 74, Mich. P.A. 1970
KENT COUNTY REMONUMENTATION

For corners in

For corners in	Located in:	Corner Code #
<u>Kent</u> (County)	Cannon Township	
1. Public Land Survey	T <u>8N</u> R <u>10W</u>	<u>H-3</u>
	T _____ R _____	_____
	T _____ R _____	_____
	T _____ R _____	_____
2. Property Controlling in Section	S _____ T _____ R _____	_____
	S _____ T _____ R _____	_____
3. Miscellaneous Property in Sec.	S _____ T _____ R _____	_____
	S _____ T _____ R _____	_____


4. Lot No. _____, Recorded Plat _____
 5. Private Claims _____

STATE OF MICHIGAN
 COUNTY OF KENT
 RECEIVED FOR RECORD
 97 OCT 15 AM 8:46
 REG. OF DEEDS
Lucy Bond

10122

Register of Deeds Stamp & File Number

I, Randy Kolehouse, in a field survey on June 24 19 97, do hereby certify that under requirements of P.A. 74 Michigan P.A. of 1970, the corner points mentioned in lines 1 and 2 above were in conformance with regulations and rules therefore as required in the current manual of survey instructions of the United States Department of the interior, Bureau of Land Management or by a decree of a Court of Law and/or that the corner points mentioned in lines 3, 4 and 5 above were in conformance with the rules of the Michigan Board of Land Surveyors or by a Decree of a Court of Law; established, re-established, monumented, re-monumented, recovered, found as expressed below:

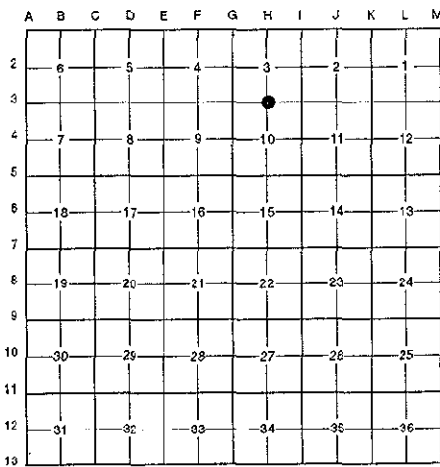

NOTE: Not more than 4 corners, all in the same town and range, may be recorded on this certificate.

A. Description of original monument and accessories and/or subsequent restoration:

H-3	1831	G.L.O. Notes	Mullett	Set Post
	N/A	Witness Map	K.C. Surveyor	Iron
	1972	L.C.R.C. #331	Williams & Works	"T" Iron
	1978	L.C.R.C. #1239	G. Hackbardt	"T" Iron
	1981	L.C.R.C. #2423	Jonker Land Surveys	Fnd. "T" Iron / Set K.C. Monument
	1989	L.C.R.C. #5245	J. Bueche	K.C. Monument

P.A. 345 1990 KENT COUNTY
 PEER APPROVED 6/26/97
 CHAIRMAN *Randy Kolehouse*

This corner was originally approved by the Kent County Remonumentation Peer Group and monumented by Rob Jonker on 11/30/81 and was recorded per L.C.R.C. #2423.

B. Description of corner evidence found and/or method applied in restoring or reestablishing corner:

H-3 Found a Standard Kent County Monument 2' South of the C/L of 9 Mile Road (bit.) running East and West on line of a tree row running North and South per L.C.R.C.'s #2423 and #5245 as set by Rob Jonker in place of a "T" iron he found at grade over a round iron 11" below grade which checked L.C.R.C.'s #1239, #331 and the K.C. Surveyor's records.

L.C.R.C. #2423

L.C.R.C. #5245

Remon. tag on SW side 15" Walnut N38°W 30.84'
 Remon. tag on N side 12" tr. W. Cherry S54°W 38.49'
 Remon. tag on E side 15" Oak S04°W 28.11'
 Remon. tag on NW side 10" Oak N37°E 37.54'
 NE corner house fnd. S41°E 116.72'


Remon. tag & nail on SW side 18" Walnut N 38° W 30.72'
 Remon. tag & nail on N side 14" tr. W. Cherry S 54° W 38.39'
 Remon. tag & nail on E side 18" Oak S 04° W 28.09'
 Remon. tag & nail on NW side 14" Oak N 37° E 37.52'
 NE corner house fnd. S 41° E 116.72'

The selected location is accepted by me and is generally accepted by professional surveyors as the best available evidence of the position of the original corner.

C. Description of monument for corner and accessories established to perpetuate locating the position of the corner:

H-3 Standard Kent County Monument

- Nail & K.C. remon. tag on SW side 18" Walnut N 38° W 30.72'
- Nail & K.C. remon. tag on N side 14" Tri-Cherry S 54° W 38.39'
- Nail & K.C. remon. tag on E side 18" Oak S 04° W 28.09'
- Nail & K.C. remon. tag on NW side 14" Oak N 37° E 37.52'

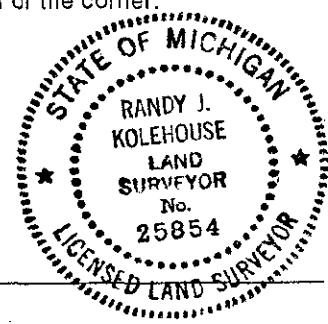

Signed by *Randy J. Kolehouse*
 EARTH TECH

Date 8/12/97

Surveyor's Michigan License No. 25854