

SURVEY & REMONUMENTATION

MAR 03 1998

LAND CORNER RECORDATION CERTIFICATE Filing Requirement of Act 74, Mich. P.A. 1970 KENT COUNTY REMONUMENTATION

For corners in **SECTION**

<u>Kent</u> (County)	Located in: Cannon Township	Corner Code #
1. Public Land Survey	T <u>8N</u> R <u>10W</u>	<u>H-5</u>
	T _____ R _____	_____
	T _____ R _____	_____
	T _____ R _____	_____
2. Property Controlling in Section	S _____ T _____ R _____	_____
	S _____ T _____ R _____	_____
3. Miscellaneous Property in Sec.	S _____ T _____ R _____	_____
	S _____ T _____ R _____	_____
4. Lot No. _____, Recorded Plat _____		
5. Private Claims _____		

REG. OF DEEDS

Lucy Board

STATE OF MICHIGAN
COUNTY OF KENT
RECEIVED FOR RECORD
97 OCT 15 AM 8:46

10123


Register of Deeds Stamp & File Number

I, Randy Kolehouse, in a field survey on June 13 19 97, do hereby certify that under requirements of P.A. 74 Michigan P.A. of 1970, the corner points mentioned in lines 1 and 2 above were in conformance with regulations and rules therefore as required in the current manual of survey instructions of the United States Department of the interior, Bureau of Land Management or by a decree of a Court of Law and/or that the corner points mentioned in lines 3, 4 and 5 above were in conformance with the rules of the Michigan Board of Land Surveyors or by a Decree of a Court of Law; established, re-established, monumented, re-monumented, recovered, found as expressed below:

NOTE: Not more than 4 corners, all in the same town and range, may be recorded on this certificate.

A. Description of original monument and accessories and/or subsequent restoration:

H-5	1831	G.L.O. Notes	Mullett	Set Post
	1963	Witness Map	K.C. Surveyor	3/4" Iron in Mon. Box
	1971	L.C.R.C. #70	Williams & Works	"T" Iron in Mon. Box
	1981	L.C.R.C. #2422	Jonker Land Surveys	Fnd. "T" Iron in Mon. Box / Set K.C. Monument in Mon. Box
	1989	L.C.R.C. #5246	J. Bueche	K.C. Monument in Mon. Box

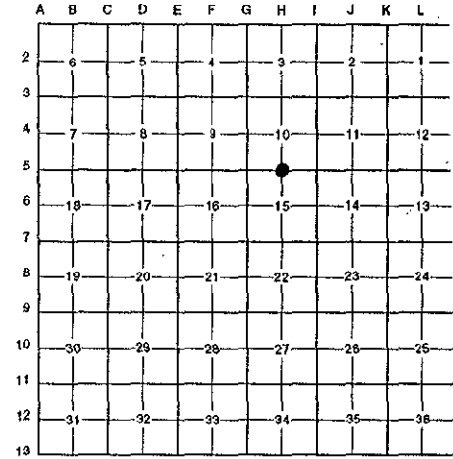

This corner was originally approved by the Kent County Remonumentation Peer Group and monumented by Williams & Works on 11/24/81 and was recorded per L.C.R.C. #2422.

B. Description of corner evidence found and/or method applied in restoring or reestablishing corner:

H-5 Found a Standard Kent County Monument 2' South of the C/L intersection of Sunfish Lake Avenue (bit.) running South and Belding Road (bit.) running East and West per L.C.R.C.'s #2422 and #5246 as set by Rob Jonker in place of a "T" iron he found in a monument which checked L.C.R.C. #70 and the K.C. Surveyor's records.

L.C.R.C. #2422

M.S.H.D. tag on NE side t. pole N40°W 46.39'
Remon. tag on SE side p. pole S32°W 58.50'
Remon. tag on SE side 6" Maple N38°E 52.19'

L.C.R.C. #5246

M.S.H.D. tag & nail on NE side t. pole N 40° W 46.39'
Remon. tag & nail on SE side p. pole S 32° W 58.50'
Remon. tag & nail on SE side 10" Maple N 38° E 52.33'
C/L M.H. S 08° E 31.90'

The selected location is accepted by me and is generally accepted by professional surveyors as the best available evidence of the position of the original corner.

C. Description of monument for corner and accessories established to perpetuate locating the position of the corner:


H-5 Standard Kent County Monument

M.S.H.D. tag & nail on NE side T. pole N 40° W 46.39'
Nail & K.C. remon. tag on SE side P. pole S 32° W 58.50'
Nail & K.C. remon. tag on SE side 10" Maple N 38° E 52.33'
C/L M.H. S 08° E 31.90'

P.A. 345 1990 KENT COUNTY

PEER APPROVED 6/26/97

CHAIRMAN Harry Huber

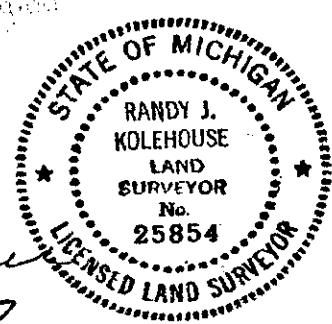

Signed by Randy Kolehouse
EARTH TECH

Date 12/12/97

Surveyor's Michigan License No. 25854