

**SURVEY & REMONUMENTATION**

MAR 03 1998

**LAND CORNER RECORDATION CERTIFICATE**  
**Filing Requirement of Act 74, Mich. P.A. 1970**  
**KENT COUNTY REMONUMENTATION**

STATE OF MICHIGAN  
 COUNTY OF KENT  
 RECEIVED FOR RECORDING  
 97 OCT 15 AM 8:46  
 REG. OF DEEDS  
*[Signature]*

**SECTION**

For corners in

<u>Kent</u> (County)	Located in: Cannon Township	Corner Code #
1. Public Land Survey	T <u>8N</u> R <u>10W</u>	<u>H-7</u>
	T _____ R _____	_____
	T _____ R _____	_____
	T _____ R _____	_____
2. Property Controlling in Section	S _____ T _____ R _____	_____
	S _____ T _____ R _____	_____
3. Miscellaneous Property in Sec.	S _____ T _____ R _____	_____
	S _____ T _____ R _____	_____

**10124**

Register of Deeds Stamp & File Number


4. Lot No. \_\_\_\_\_, Recorded Plat \_\_\_\_\_  
 5. Private Claims \_\_\_\_\_

I, Randy Kolehouse, in a field survey on June 13 19 97, do hereby certify that under requirements of P.A. 74 Michigan P.A. of 1970, the corner points mentioned in lines 1 and 2 above were in conformance with regulations and rules therefore as required in the current manual of survey instructions of the United States Department of the Interior, Bureau of Land Management or by a decree of a Court of Law and/or that the corner points mentioned in lines 3, 4 and 5 above were in conformance with the rules of the Michigan Board of Land Surveyors or by a Decree of a Court of Law; established, re-established, monumented, re-monumented, recovered, found as expressed below:

**NOTE: Not more than 4 corners, all in the same town and range, may be recorded on this certificate.**

A. Description of original monument and accessories and/or subsequent restoration:

H-7	1831	G.L.O. Notes	Mullet	Set Post
	1936	Witness Map	K.C. Surveyor	Iron
	1975	L.C.R.C. #876	Medema, Van Kooten & Assoc.	Round Iron
	1981	L.C.R.C. #2421	Jonker Land Surveys	Fnd. 3/4" Iron / Set K.C. Monument
	1989	L.C.R.C. #5247	J. Bueche	K.C. Monument

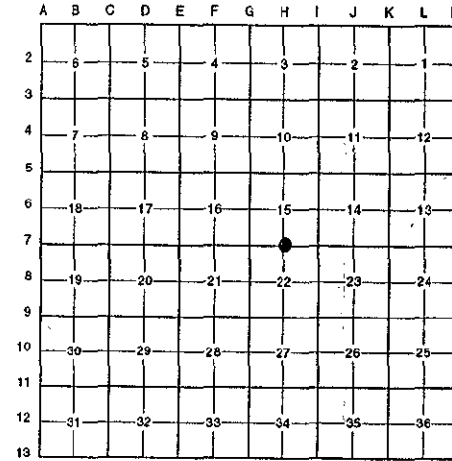

This corner was originally approved by the Kent County Remonumentation Peer Group and monumented by Rob Jonker on 11/30/81 and was recorded per L.C.R.C. #2421.

B. Description of corner evidence found and/or method applied in restoring or reestablishing corner:

H-7 Found a Standard Kent County Monument on the C/L of Sunfish Lake Avenue (bit.) running North and South on line of a tree row running West and a brush row running East per L.C.R.C.'s #2421 and #5247 as set by Rob Jonker in place of a 3/4" iron he found which checked L.C.R.C. #876 and the K.C. Surveyor's records.

L.C.R.C. #2421

- Remon. tag on N side 34" Maple S33°E 46.03'
- Remon. tag on S side p. pole N88°W 60.86'
- Remon. tag on NW side 38" Maple S38°W 36.10'
- Remon. tag on NW side 30" Oak N50°E 35.51'
- Remon. tag on SW side 5" Sassafras N37°W 43.80'

L.C.R.C. #5247

- Remon. tag & nail on N side 36" Maple S 33° E 46.03'
- Remon. tag & nail on S side p. pole N 88° W 60.86'
- Remon. tag & nail on NW side 32" Oak N 50° E 36.16'
- Remon. tag & nail on SW side 6" Sassafras N 30° W 40.46'

The selected location is accepted by me and is generally accepted by professional surveyors as the best available evidence of the position of the original corner.

C. Description of monument for corner and accessories established to perpetuate locating the position of the corner:


H-7 Standard Kent County Monument

- Nail & K.C. remon. tag on N side 36" Maple S 33° E 46.03'
- Nail & K.C. remon. tag on S side P. pole N 88° W 60.86'
- Nail & K.C. remon. tag on NW side 32" Oak N 50° E 36.16'
- Nail & K.C. remon. tag on SW side 6" Sassafras N 30° W 40.46'

P.A. 345 1990 KENT COUNTY

PEER APPROVED 6/26/97

CHAIRMAN [Signature]

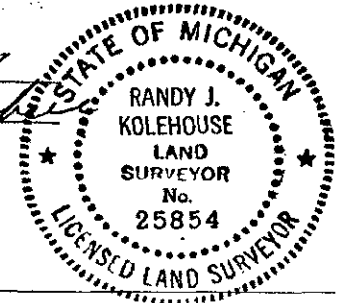

Signed by Randy J. Kolehouse  
 EARTH TECH

Date 8/12/97

Surveyor's Michigan License No. 25854