

SURVEY & REMONUMENTATION
 \$7.00
 \$2.00
 MAR 03 1998

LAND CORNER RECORDATION CERTIFICATE
 Filing Requirement of Act 74, Mich. P.A. 1970
 KENT COUNTY REMONUMENTATION

For corners in **SECTION**
Kent
 (County)

Located in:	Cannon Township	Corner Code #
1. Public Land Survey	T <u>8N</u> R <u>10W</u>	<u>H-11</u>
	T _____ R _____	_____
	T _____ R _____	_____
	T _____ R _____	_____
2. Property Controlling in Section	S _____ T _____ R _____	_____
	S _____ T _____ R _____	_____
3. Miscellaneous Property in Sec.	S _____ T _____ R _____	_____
	S _____ T _____ R _____	_____


REG. OF DEEDS
Lucy Sand
 97 DEC 15 AM 10:44
 STATE OF MICHIGAN
 COUNTY OF KENT
 RECEIVED FOR RECORD

10405

Register of Deeds Stamp & File Number

4. Lot No. _____, Recorded Plat _____
 5. Private Claims _____

I, Randy Kolehouse, in a field survey on November 19 19 97, do hereby certify that under requirements of P.A. 74 Michigan P.A. of 1970, the corner points mentioned in lines 1 and 2 above were in conformance with regulations and rules therefore as required in the current manual of survey instructions of the United States Department of the interior, Bureau of Land Management or by a decree of a Court of Law and/or that the corner points mentioned in lines 3, 4 and 5 above were in conformance with the rules of the Michigan Board of Land Surveyors or by a Decree of a Court of Law; established, re-established, monumented, re-monumented, recovered, found as expressed below:

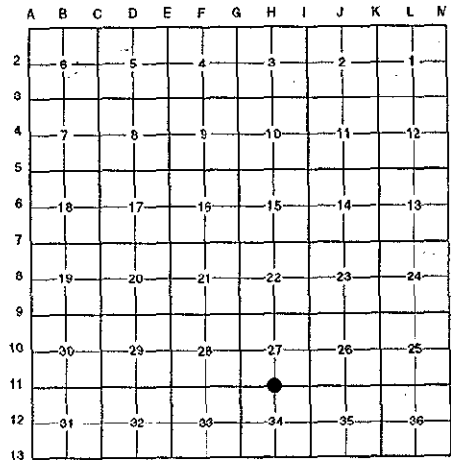

NOTE: Not more than 4 corners, all in the same town and range, may be recorded on this certificate.

A. Description of original monument and accessories and/or subsequent restoration:

H-11	1831	G.L.O. Notes	Mullett	Set Post
	1944	Witness Map	K.C. Surveyor	Leaded Stone
	1978	L.C.R.C. #1221	William Byl	Iron Pipe
	1981	L.C.R.C. #2419	Jonker Land Surveys	Fnd. 3/4" Iron Pipe / Set K.C. Monument
	1989	L.C.R.C. #5249	J. Bueche	K.C. Monument

P.A. 345 1990 KENT COUNTY
PEER APPROVED 10/30/97
CHAIRMAN *Harry Phakee*

This corner was originally approved by the Kent County Remonumentation Peer Group and monumented by Rob Jonker on 12/1/81 and was recorded per L.C.R.C. #2419.

B. Description of corner evidence found and/or method applied in restoring or reestablishing corner:

H-11 Found a broken Kent County Monument 5' South of the C/L of 5 Mile Road (gravel) running East and West per L.C.R.C.'s #2419 and #5249 as set by Rob Jonker in place of a 3/4" iron pipe he found at grade over a 2'x2'x3' pointed leaded stone 14" below grade which checked L.C.R.C. #1221 and the K.C. Surveyor's records.

L.C.R.C. #2419

Remon. tag on NW side 16" Pine N 69° E 145.8'
 Remon. tag on E side 8" Pine N 19° E 122.0'
 3/4" round iron South 32.91'

L.C.R.C. #5249


Remon. tag & nail on NE side 12" Pine S 35° E 100.71' (m. 100.58')
 Remon. tag & nail on NW side 18" Pine N 69° E 145.8' (m. 146.02')
 Remon. tag & nail on E side 12" Pine N 19° E 122.0' (m. 122.08')
 3/4" round iron South 32.91' (m. 32.68')
 N-S C.M.P. under road, West, 69' m/l (m. 70.0' ±)

The selected location is accepted by me and is generally accepted by professional surveyors as the best available evidence of the position of the original corner.

C. Description of monument for corner and accessories established to perpetuate locating the position of the corner:

H-11 Reset a Standard Kent County Monument Encased in Concrete Over Stone

Nail & K.C. remon. tag on NE side 14" Tamarack S 40° E 100.58'
 Nail & K.C. remon. tag on NW side 20" Tamarack N 69° E 146.02'
 Nail & K.C. remon. tag on E side 12" Tamarack N 20° E 122.08'
 3/4" "C" iron S 05° W 32.68'

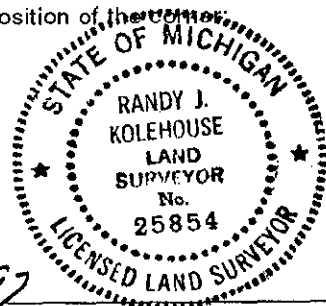

Signed by *Randy J. Kolehouse* Date 12/5/97
 EARTH TECH

Surveyor's Michigan License No. 25854