

SURVEY & REMONUMENTATION
 \$7.00
 \$2.00 MAR 03 1998

LAND CORNER RECORDATION CERTIFICATE
Filing Requirement of Act 74, Mich. P.A. 1970
KENT COUNTY REMONUMENTATION

For corners in **SECTION**
Kent
 (County)

	Located in:	Cannon Township	Corner Code #
1. Public Land Survey	T <u>8N</u> R <u>10W</u>		<u>H-13</u>
	T _____ R _____		_____
	T _____ R _____		_____
	T _____ R _____		_____
2. Property Controlling in Section	S _____ T _____ R _____		_____
	S _____ T _____ R _____		_____
3. Miscellaneous Property in Sec.	S _____ T _____ R _____		_____
	S _____ T _____ R _____		_____

REG. OF DEEDS
Luci Standa
 97 NOV 14 AM 9:02
 STATE OF MICHIGAN
 COUNTY OF KENT
 RECEIVED FOR RECORD

10339
 Register of Deeds Stamp & File Number


4. Lot No. _____, Recorded Plat _____
 5. Private Claims _____

I, Randy Kolehouse, in a field survey on August 15 19 97, do hereby certify that under requirements of P.A. 74 Michigan P.A. of 1970, the corner points mentioned in lines 1 and 2 above were in conformance with regulations and rules therefore as required in the current manual of survey instructions of the United States Department of the interior, Bureau of Land Management or by a decree of a Court of Law and/or that the corner points mentioned in lines 3, 4 and 5 above were in conformance with the rules of the Michigan Board of Land Surveyors or by a Decree of a Court of Law; established, re-established, monumented, re-monumented, recovered, found as expressed below:

NOTE: Not more than 4 corners, all in the same town and range, may be recorded on this certificate.

A. Description of original monument and accessories and/or subsequent restoration:

H-13	1831	G.L.O. Notes	Mullett	Set Post
	1968	Witness Map	K.C. Surveyor	Pipe
	1978	L.C.R.C. #1198	R. Jonker	2" Iron Pipe
	1978	L.C.R.C. #1221	William Byl	"T" Iron / Set 1/2" Re-rod w/Cap
	1981	L.C.R.C. #1776	Williams & Works	Fnd. 1/2" Re-rod w/Cap / Set K.C. Monument
	1989	L.C.R.C. #5250	J. Bueche	K.C. Monument

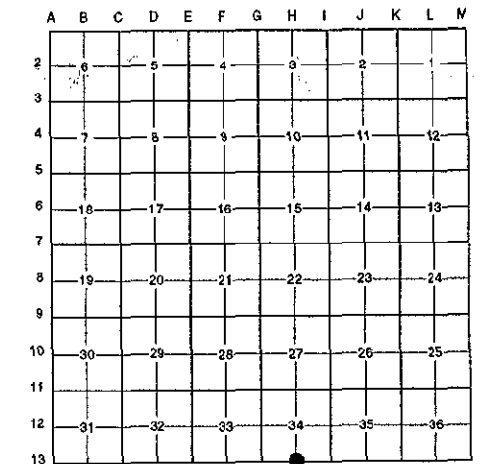

P.A. 345 1990 KENT COUNTY
 PEER APPROVED 8/28/97
 CHAIRMAN Harry Hobbes

Note: This corner is not common with H-1, T7N, R10W.

This corner was originally approved by the Kent County Remonumentation Peer Group and monumented by Williams & Works on 1/26/81 and was recorded per L.C.R.C. #1776.

B. Description of corner evidence found and/or method applied in restoring or reestablishing corner:

H-13 Found a Standard Kent County Monument (broken) 5.0' ± North of the C/L of 4 Mile Road (gravel) running East and West per L.C.R.C.'s #1776 and #5250 as set by Williams & Works in place of a 1/2" re-rod w/cap they found which checked L.C.R.C.'s #1221, #1198 and the K.C. Surveyor's records.

L.C.R.C. #1776

L.C.R.C. #5250

K.C. Remon. Tag & Nail in W Side 8" Willow in Clump S 25°E 50.34'
 K.C. Remon. Tag & Nail in N Side 10" Elm S 80°W 144.22'
 K.C. Remon. Tag & Nail in E Side 4" Elm N 15°E 74.77'

Remon. tag & nail in SW side 24" Twin Willow S 40° E 50.97'
 Remon. tag & nail in W side 12" Willow in Clump S 25° E 50.34'
 Remon. tag & nail in N side 12" Elm S 80° W 143.93' (m. 143.97')
 Remon. tag & nail in E side 8" Elm N 15° E 74.90' (5' high) (m. 74.84')
 K.C. Mon. (H-1, 7-10) West 220.98'

The selected location is accepted by me and is generally accepted by professional surveyors as the best available evidence of the position of the original corner.


C. Description of monument for corner and accessories established to perpetuate locating the position of the corner:

H-13 Reset a Standard Kent County Monument

- Nail & K.C. remon. tag on NE side 20" Twin Willow S 50° E 52.52'
- Nail & K.C. remon. tag on W side 12" Willow in clump S 25° E 50.34'
- Nail & K.C. remon. tag on N side 12" Elm S 80° W 143.97'
- Nail & K.C. remon. tag on E side 8" Elm N 15° E 74.84'
- K.C. Mon., H-1, T7N, R10W, West 221.05'

Signed by Randy J. Kolehouse
 EARTH TECH

Date 9/23/97

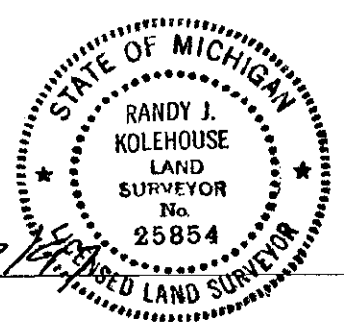

Surveyor's Michigan License No. 25854