

SURVEY & REMONUMENTATION

MAR 03 1998

LAND CORNER RECORDATION CERTIFICATE Filing Requirement of Act 74, Mich. P.A. 1970 KENT COUNTY REMONUMENTATION

For corners in **SECTION**

Kent (County)	Located in: Cannon Township	Corner Code #
1. Public Land Survey	T <u>8N</u> R <u>10W</u>	<u>I-1</u>
	T _____ R _____	_____
	T _____ R _____	_____
	T _____ R _____	_____
2. Property Controlling in Section	S _____ T _____ R _____	_____
	S _____ T _____ R _____	_____
3. Miscellaneous Property in Sec.	S _____ T _____ R _____	_____
	S _____ T _____ R _____	_____

REG. OF DEEDS
William Byl
97 OCT 15 AM 8:47
STATE OF MICHIGAN
COUNTY OF KENT
RECEIVED FOR RECORD

10126

Register of Deeds Stamp & File Number

4. Lot No. _____, Recorded Plat _____
5. Private Claims _____

I, Randy Kolehouse, in a field survey on June 24 19 97, do hereby certify that under requirements of P.A. 74 Michigan P.A. of 1970, the corner points mentioned in lines 1 and 2 above were in conformance with regulations and rules therefore as required in the current manual of survey instructions of the United States Department of the interior, Bureau of Land Management or by a decree of a Court of Law and/or that the corner points mentioned in lines 3, 4 and 5 above were in conformance with the rules of the Michigan Board of Land Surveyors or by a Decree of a Court of Law; established, re-established, monumented, re-monumented, recovered, found as expressed below:

A	B	C	D	E	F	G	H	I	J	K	L	M
2	6	5	4	3	2	1						
3												
4	7	8	9	10	11	12						
5												
6	18	17	16	15	14	13						
7												
8	19	20	21	22	23	24						
9												
10	30	29	28	27	26	25						
11												
12	31	32	33	34	35	36						
13												

NOTE: Not more than 4 corners, all in the same town and range, may be recorded on this certificate.

A. Description of original monument and accessories and/or subsequent restoration:

I-1 Post	G.L.O. Notes	Mullett	Set
1831	Witness Map	K.C. Surveyor	1" Pipe in Monument Box
1945	L.C.R.C. #831	Williams & Works	1/2" Iron in Monument Box
1975	L.C.R.C. #873	Medema, Van Kooten & Assoc.	1/2" Iron in Monument Box
1984	L.C.R.C. #3982	William Byl	Fnd. 1" Iron in Mon. Box / Set K.C. Monument

Note: This corner is not common with I-13, T9N, R10W.

This corner was originally approved by the Kent County Remonumentation Peer Group and monumented by William Byl on 10/16/84 and was recorded per L.C.R.C. #3982.

B. Description of corner evidence found and/or method applied in restoring or reestablishing corner:

I-1 Found a Standard Kent County Monument on the Township line in a monument box 3' North of the C/L intersection of Young Avenue (bit.) running South and 10 Mile Road (bit.) running East and West per L.C.R.C. #3982 as set by William Byl in place of a 1" iron he found in a monument box 131.97' East of Courtland Township corner and 0.14' South of the South line of Section 35, T9N, R10W, which checked L.C.R.C.'s #873, #831 and the K.C. Surveyor's records.

L.C.R.C. #3982


SE cor. conc. block chimney (Hse. #8015) N 05° E 94.91'
Nail & tag, N sd. 40" Oak S 75° E 111.23'
Nail & tag N sd. 48" Boxelder N 60° W 76.41'
Kent County Monument, Sec. cor. bet, 34 & 35 N 90° W 131.97'

P.A. 345 1990 KENT COUNTY,
PEER APPROVED 6/26/97
CHAIRMAN *Henry Stuber*

The selected location is accepted by me and is generally accepted by professional surveyors as the best available evidence of the position of the original corner.

C. Description of monument for corner and accessories established to perpetuate locating the position of the corner:

I-1 Standard Kent County Monument in a Monument Box
SE cor. conc. chimney (Hse. #8015) N 05° E 94.91'
Nail & K.C. remon. tag on E side 18" Poplar N 40° E 65.05'
Nail & K.C. remon. tag on N side 40" Oak S 75° E 111.23'
Nail & K.C. remon. tag on N side 48" Box Elder N 60° W 76.41'
K.C. Mon., I-13, T9N, R10W, West 131.97'

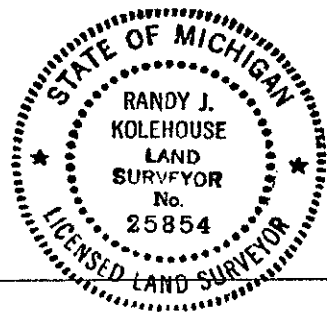

Signed by *Randy J. Kolehouse* Date 01/12/97
EARTH TECH
Surveyor's Michigan License No. 25854