

**SURVEY & REMONUMENTATION**

MAR 03 1998

**LAND CORNER RECORDATION CERTIFICATE**  
**Filing Requirement of Act 74, Mich. P.A. 1970**  
**KENT COUNTY REMONUMENTATION**

For corners in **SECTION**  
Kent  
 (County)


Located in: Cannon Township Corner Code #  
 1. Public Land Survey T 8N R 10W 1-3  
 T \_\_\_\_\_ R \_\_\_\_\_  
 T \_\_\_\_\_ R \_\_\_\_\_  
 T \_\_\_\_\_ R \_\_\_\_\_  
 2. Property Controlling S \_\_\_\_\_ T \_\_\_\_\_ R \_\_\_\_\_  
 in Section S \_\_\_\_\_ T \_\_\_\_\_ R \_\_\_\_\_  
 3. Miscellaneous S \_\_\_\_\_ T \_\_\_\_\_ R \_\_\_\_\_  
 Property in Sec. S \_\_\_\_\_ T \_\_\_\_\_ R \_\_\_\_\_

REG. OF DEEDS  
*Lucy Stand*  
 97 OCT 15 AM 8:47  
 STATE OF MICHIGAN  
 COUNTY OF KENT  
 RECEIVED FOR RECORD

**10128**  
 Register of Deeds Stamp & File Number

4. Lot No. \_\_\_\_\_, Recorded Plat \_\_\_\_\_  
 5. Private Claims \_\_\_\_\_

I, Randy Kolehouse, in a field survey on June 24 19 97, do hereby certify that under requirements of P.A. 74 Michigan P.A. of 1970, the corner points mentioned in lines 1 and 2 above were in conformance with regulations and rules therefore as required in the current manual of survey instructions of the United States Department of the Interior, Bureau of Land Management or by a decree of a Court of Law and/or that the corner points mentioned in lines 3, 4 and 5 above were in conformance with the rules of the Michigan Board of Land Surveyors or by a Decree of a Court of Law; established, re-established, monumented, re-monumented, recovered, found as expressed below:

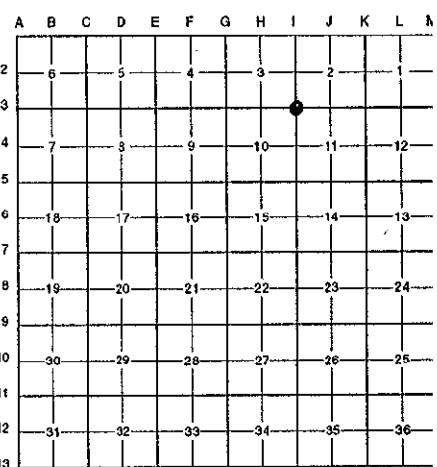

**NOTE: Not more than 4 corners, all in the same town and range, may be recorded on this certificate.**

**A. Description of original monument and accessories and/or subsequent restoration:**

I-3	1831	G.L.O. Notes	Mullett	Set Post
	1944	Witness Map	K.C. Surveyor	1-1/2" Iron Pipe
	1975	L.C.R.C. #873	Medema, Van Kooten & Assoc.	3/4" Iron
	1978	L.C.R.C. #1239	G. Hackbardt	3/4" Iron
	1981	L.C.R.C. #2417	Jonker Land Surveys	Fnd. 3/4" Iron / Set K.C. Monument
	1989	L.C.R.C. #5252	J. Bueche	Reset K.C. Monument

**P.A. 345 1990 KENT COUNTY**  
**PEER APPROVED 6/26/97**  
**CHAIRMAN Randy Kolehouse**

This corner was originally approved by the Kent County Remonumentation Peer Group and monumented by Rob Jonker on 11/24/81 and was recorded per L.C.R.C. #2417.

**B. Description of corner evidence found and/or method applied in restoring or reestablishing corner:**

I-3 Found a Standard Kent County Monument at the C/L intersection of 9 Mile Road (bit.) running East and West and Young Avenue (bit.) running North and South per L.C.R.C.'s #2417 and #5252 as set by Rob Jonker in place of a 3/4" iron he found at grade inside of a 2" x 30" crimped iron 18" below grade and reset by J. Bueche which checked L.C.R.C.'s #1239, #873 and the K.C. Surveyor's records.

**L.C.R.C. #2417**

Face stop sign post N75°E 56.15'  
 Remon. tag on NW side fence post S39°W 53.14'  
 Remon. tag on E side 32" Oak S19°E 71.18'

**L.C.R.C. #5252**

Remon. tag & nail on NW side fence post S 39° W 53.14'  
 Remon. tag & nail on S side 10" Apple N 45° W 128.72'  
 Remon. tag & nail on NW side 8" dia. wood fence post S 75° W 113.03'

The selected location is accepted by me and is generally accepted by professional surveyors as the best available evidence of the position of the original corner.

**C. Description of monument for corner and accessories established to perpetuate locating the position of the corner:**

I-3 Standard Kent County Monument

- Nail & K.C. remon. tag on SW side P. pole S 35° E 48.92'
- Nail & K.C. remon. tag on NW side fence post S 39° W 53.14'
- Nail & K.C. remon. tag on S side 10" Apple N 45° W 128.72'
- Nail & K.C. remon. tag on NW side 8" wood fence post S 75° W 113.03'



Signed by Randy J. Kolehouse  
 EARTH TECH

Date 8/12/97

Surveyor's Michigan License No. 25854