

SURVEY & REMONUMENTATION

\$7.00
\$2.00

MAR 03 1998

LAND CORNER RECORDATION CERTIFICATE
Filing Requirement of Act 74, Mich. P.A. 1970
KENT COUNTY REMONUMENTATION

SECTION

For corners in

Kent (County)	Located in: Cannon Township	Corner Code #
1. Public Land Survey	T <u>8N</u> R <u>10W</u>	<u>1-9</u>
	T _____ R _____	_____
	T _____ R _____	_____
	T _____ R _____	_____
2. Property Controlling in Section	S _____ T _____ R _____	_____
	S _____ T _____ R _____	_____
3. Miscellaneous Property in Sec.	S _____ T _____ R _____	_____
	S _____ T _____ R _____	_____

STATE OF MICHIGAN
COUNTY OF KENT
RECEIVED FOR RECORD
97 NOV 14 AM 9:02
REG. OF DEEDS
Jonker

10342

Register of Deeds Stamp & File Number


- 4. Lot No. _____, Recorded Plat _____
- 5. Private Claims _____

I, Randy Kolehouse, in a field survey on August 18 19 97, do hereby certify that under requirements of P.A. 74 Michigan P.A. of 1970, the corner points mentioned in lines 1 and 2 above were in conformance with regulations and rules therefore as required in the current manual of survey instructions of the United States Department of the interior, Bureau of Land Management or by a decree of a Court of Law and/or that the corner points mentioned in lines 3, 4 and 5 above were in conformance with the rules of the Michigan Board of Land Surveyors or by a Decree of a Court of Law; established, re-established, monumented, re-monumented, recovered, found as expressed below:

NOTE: Not more than 4 corners, all in the same town and range, may be recorded on this certificate.

A. Description of original monument and accessories and/or subsequent restoration:

I-9	1831	G.L.O. Notes	Mullett	Set Post
	N/A	Witness Map	K.C. Surveyor	Iron
	1978	L.C.R.C. #1130	Williams & Works	1" Iron
	1981	L.C.R.C. #2434	Jonker Land Surveys	Fnd. 1" Iron / Set K.C. Monument
	1989	L.C.R.C. #5258	J. Bueche	K.C. Monument

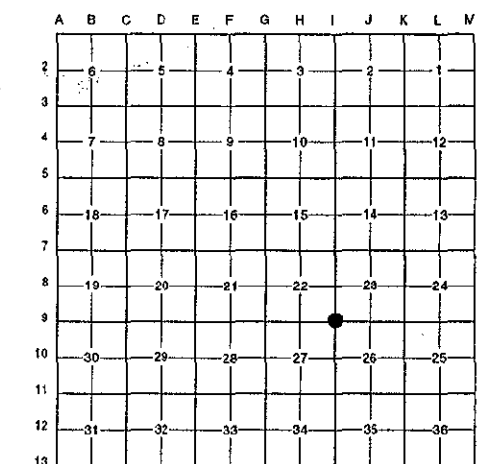

P.A. 345 1990 KENT COUNTY
PEER APPROVED 9/28/97
CHAIRMAN Randy Kolehouse

This corner was originally approved by the Kent County Remonumentation Peer Group and monumented by Rob Jonker on 12/9/81 and was recorded per L.C.R.C. #2434.

B. Description of corner evidence found and/or method applied in restoring or reestablishing corner:

I-9 Found a Standard Kent County Monument 700' ± West of the C/L of Joyce Road (bit.) running North and South, 40' North of a chain link fence running East and West, on line of an old fence row running North per L.C.R.C.'s #2434 and #5258 as set by Rob Jonker in place of a 1" iron he found under the West side of an old wood fence corner post in a pile of stones which checked L.C.R.C. #1130 and the K.C. Surveyor's records.

L.C.R.C. #2434

Face of steel fence post at grade S85°W 3.05'
Remon. tag on W side 10" Maple North 2.02'
Remon. tag on N side 6" Maple N88°E 7.14'
Remon. tag on N side 4" Pine N64°W 21.99'

L.C.R.C. #5258

Face of steel fence post at grade S 85° W 3.05'
Remon. tag & nail on W side 12" Maple N 2.02'
Remon. tag & nail on N side 10" Maple N 88° E 7.25'
Remon. tag & nail on N side 8" Pine N 64° W 22.05'

The selected location is accepted by me and is generally accepted by professional surveyors as the best available evidence of the position of the original corner.

C. Description of monument for corner and accessories established to perpetuate locating the position of the corner:

I-9 Standard Kent County Monument

Face of steel fence post at grade S 85° W 3.05'
Nail & K.C. remon. tag on W side 12" Maple North 2.02'
Nail & K.C. remon. tag on N side 10" Maple N 88° E 7.25'
Nail & K.C. remon. tag on N side 8" Pine N 64° W 22.05'

Signed by Randy J. Kolehouse Date 9/23/97
EARTH TECH
Surveyor's Michigan License No. 25854

