

SURVEY & REMONUMENTATION

MAR 03 1998

LAND CORNER RECORDATION CERTIFICATE
Filing Requirement of Act 74, Mich. P.A. 1970
KENT COUNTY REMONUMENTATION

SECTION

For corners in

<u>Kent</u> (County)	Located in: Cannon Township	Corner Code #	
1. Public Land Survey	T <u>8N</u> R <u>10W</u>	<u>I-10</u>	
	T _____ R _____	_____	
	T _____ R _____	_____	
	T _____ R _____	_____	
2. Property Controlling in Section	S _____ T _____ R _____	_____	
	S _____ T _____ R _____	_____	
3. Miscellaneous Property in Sec.	S _____ T _____ R _____	_____	
	S _____ T _____ R _____	_____	
4. Lot No. _____, Recorded Plat _____			
5. Private Claims _____			

STATE OF MICHIGAN
 COUNTY OF KENT
 RECEIVED FOR RECORD
 97 OCT 15 AM 8:47
 REG. OF DEEDS
Eric Spauld

10131
 Register of Deeds Stamp & File Number

I, Randy Kolehouse, in a field survey on June 19 19 97, do hereby certify that under requirements of P.A. 74 Michigan P.A. of 1970, the corner points mentioned in lines 1 and 2 above were in conformance with regulations and rules therefore as required in the current manual of survey instructions of the United States Department of the Interior, Bureau of Land Management or by a decree of a Court of Law and/or that the corner points mentioned in lines 3, 4 and 5 above were in conformance with the rules of the Michigan Board of Land Surveyors or by a Decree of a Court of Law; established, re-established, monumented, re-monumented, recovered, found as expressed below:

NOTE: Not more than 4 corners, all in the same town and range, may be recorded on this certificate.

A. Description of original monument and accessories and/or subsequent restoration:

I-10	1831	G.L.O. Notes	Mullett	Set Post
	196	Witness Map	K.C. Surveyor	Iron
	1973	L.C.R.C. #595	Exxel Engineering	1/2" Iron
	1981	L.C.R.C. #2435	Jonker Land Surveys	Fnd. 1/2" Iron / Set K.C. Monument
	1989	L.C.R.C. #5259	J. Bueche	K.C. Monument

This corner was originally approved by the Kent County Remonumentation Peer Group and monumented by Rob Jonker on 12/7/81 and was recorded per L.C.R.C. #2435.

B. Description of corner evidence found and/or method applied in restoring or reestablishing corner:

I-10 Found a Standard Kent County Monument 1.5' East of the C/L of Honey Creek Avenue (bit.) running North and South on occupation line running East and West per L.C.R.C.'s #2435 and #5259 as set by Rob Jonker in place of a 1/2" iron he found at grade over a 1" iron 1.7' below grade which checked L.C.R.C. #595 and the K.C. Surveyor's records.

L.C.R.C. #2435

Remon. tag on N side p. pole S86°E 28.36'
 Chisled "X" on H/W S 32° E 36.39'

L.C.R.C. #5259

Remon. tag & nail on N side p. pole S 86° E 28.36'
 Remon. tag & nail on NW side group 3 - 8" Maples N 40° E 50.77'
 Chisled "X" on H/W S 32° E 36.39'


P.A. 345 1990 KENT COUNTY
 PEER APPROVED 6/26/97
 CHAIRMAN Randy Kolehouse

The selected location is accepted by me and is generally accepted by professional surveyors as the best available evidence of the position of the original corner.

C. Description of monument for corner and accessories established to perpetuate locating the position of the corner:

I-10 Standard Kent County Monument

Nail & K.C. remon. tag on N side P. pole S 86° E 28.36'
 Nail & K.C. remon. tag on S side T. pole N 90° W 24.60'
 Nail & K.C. remon. tag on NW side group 3 - 8" Maples N 40° E 50.77'
 Chisled "X" on headwall S 32° E 36.39'

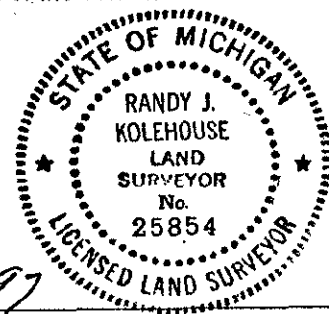

Signed by Randy J. Kolehouse Date 8/12/97
 EARTH TECH

Surveyor's Michigan License No. 25854

