

MAR 03 1998

SECTION

LAND CORNER RECORDATION CERTIFICATE
Filing Requirement of Act 74, Mich. P.A. 1970
KENT COUNTY REMONUMENTATION

For corners in

Kent (County)

Located in: Cannon Township

Corner Code #

Table with 4 columns: Item, Survey Type, Section/Range/Township, and Corner Code #. Includes rows for Public Land Survey, Property Controlling in Section, and Miscellaneous Property in Sec.

REG. OF DEEDS

Handwritten signature

97 OCT 15 AM 8:47

STATE OF MICHIGAN COUNTY OF KENT RECEIVED FOR RECORD

10132

Register of Deeds Stamp & File Number

4. Lot No. , Recorded Plat
5. Private Claims

I, Randy Kolehouse, in a field survey on June 19 19 97, do hereby certify that under requirements of P.A. 74 Michigan P.A. of 1970, the corner points mentioned in lines 1 and 2 above were in conformance with regulations and rules therefore as required in the current manual of survey instructions of the United States Department of the Interior, Bureau of Land Management or by a decree of a Court of Law and/or that the corner points mentioned in lines 3, 4 and 5 above were in conformance with the rules of the Michigan Board of Land Surveyors or by a Decree of a Court of Law; established, re-established, monumented, re-monumented, recovered, found as expressed below:


NOTE: Not more than 4 corners, all in the same town and range, may be recorded on this certificate.

A. Description of original monument and accessories and/or subsequent restoration:

Table listing survey details: I-11 1831 G.L.O. Notes Mullett Set Post, 1927 Witness Map K.C. Surveyor Painted Stone, 1944 Witness Map K.C. Surveyor Pipe, 1972 L.C.R.C. #156 Medema, Van Kooten & Assoc. Monument Box, 1981 L.C.R.C. #2436 Jonker Land Surveys Fnd. RR Spike in Mon. Box / Set K.C. Monument in Mon. Box, 1989 L.C.R.C. #5260 J. Bueche K.C. Monument

P.A. 345 1990 KENT COUNTY

PEER APPROVED 8/26/97 CHAIRMAN [Signature]

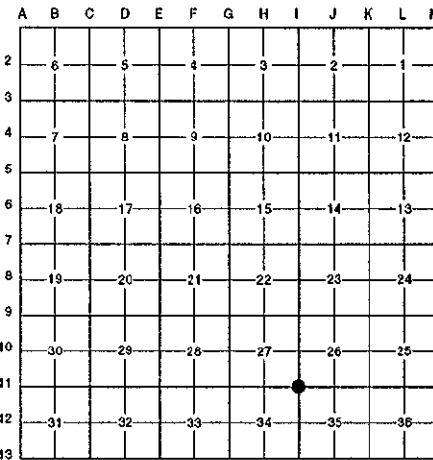

This corner was originally approved by the Kent County Remonumentation Peer Group and monumented by Rob Jonker on 12/7/81 and was recorded per L.C.R.C. #2436.

B. Description of corner evidence found and/or method applied in restoring or reestablishing corner:

I-11 Found a Standard Kent County Monument on the C/L of Honey Creek Avenue (bit.) running North and South, 8' ± South of the C/L of 5 Mile Road (bit.) running East, and 10' ± South of the C/L of 5 Mile Road (gravel) running West per L.C.R.C.'s #2436 and #5260 as set by Rob Jonker in place of a railroad spike he found in a monument box over a 3" x 30" pipe 8" below grade which checked L.C.R.C. #156 and the 1927 and 1944 K.C. Surveyor's records.

L.C.R.C. #2436

L.C.R.C. #5260

Remon. tag on NW side t. pole N27°E 79.88'
Remon. tag on SE side 32" Maple S42°W 45.03'

Remon. tag & nail on SW side 28" Oak N 28° W 57.42'
Remon. tag & nail on NW side t. pole N 27° E 79.88'
Remon. tag & nail on NW side 16" Elm N 53° E 69.62'
Remon. tag & nail on SE side 36" Maple S 42° W 45.03'

The selected location is accepted by me and is generally accepted by professional surveyors as the best available evidence of the position of the original corner.

C. Description of monument for corner and accessories established to perpetuate locating the position of the corner:

I-11 Standard Kent County Monument

- Nail & K.C. remon. tag on S side 28" Oak N 28° W 57.42'
Nail & K.C. remon. tag on NW side T. pole N 27° E 79.88'
Nail & K.C. remon. tag on NW side 16" Elm N 53° E 69.62'
Nail & K.C. remon. tag on SE side 36" Maple S 42° W 45.03'

Signed by Randy J. Kolehouse EARTH TECH

Date 8/12/97

Surveyor's Michigan License No. 25854

