

SURVEY & REMONUMENTATION

MAR 03 1998

LAND CORNER RECORDATION CERTIFICATE
Filing Requirement of Act 74, Mich. P.A. 1970
KENT COUNTY REMONUMENTATION

For corners in **SECTION**

Kent (County)	Located in: Cannon Township	Corner Code #
1. Public Land Survey	T <u>8N</u> R <u>10W</u>	<u>J-1</u>
	T _____ R _____	_____
	T _____ R _____	_____
	T _____ R _____	_____
2. Property Controlling in Section	S _____ T _____ R _____	_____
	S _____ T _____ R _____	_____
3. Miscellaneous Property in Sec.	S _____ T _____ R _____	_____
	S _____ T _____ R _____	_____
4. Lot No. _____, Recorded Plat _____		
5. Private Claims _____		

STATE OF MICHIGAN
 COUNTY OF KENT
 RECEIVED FOR RECORD
 97 OCT 15 AM 8:47
 REG. OF DEEDS
W. J. Byrd

10135

Register of Deeds Stamp & File Number

A	B	C	D	E	F	G	H	I	J	K	L	M
2	6	5	4	3	2	1						
3												
4	7	8	9	10	11	12						
5												
6	16	17	16	15	14	13						
7												
8	19	20	21	22	23	24						
9												
10	30	29	28	27	26	25						
11												
12	31	32	33	34	35	36						
13												

I, Randy Kolehouse, in a field survey on 6/24/97 19 97, do hereby certify that under requirements of P.A. 74 Michigan P.A. of 1970, the corner points mentioned in lines 1 and 2 above were in conformance with regulations and rules therefore as required in the current manual of survey instructions of the United States Department of the interior, Bureau of Land Management or by a decree of a Court of Law and/or that the corner points mentioned in lines 3, 4 and 5 above were in conformance with the rules of the Michigan Board of Land Surveyors or by a Decree of a Court of Law; established, re-established, monumented, re-monumented, recovered, found as expressed below:

NOTE: Not more than 4 corners, all in the same town and range, may be recorded on this certificate.

A. Description of original monument and accessories and/or subsequent restoration:

J-1 This corner was not originally set by the G.L.O.

1961	Witness Map	K.C. Surveyor	Monument Box
1949-72	Notes	Williams & Works	Iron
1972	L.C.R.C. #135	Williams & Works	1" Iron in Mon. Box
1984	L.C.R.C. #3983	William Byl	Fnd. 1" Iron in Mon. Box / Set K.C. Monument in Mon. Box

Note: This corner is not common with J-13, T9N, R10W.

This corner was originally approved by the Kent County Remonumentation Peer Group and monumented by William Byl on 10/16/84 and was recorded per L.C.R.C. #3983.

B. Description of corner evidence found and/or method applied in restoring or reestablishing corner:

J-1 Found a Standard Kent County Monument in a monument box on the Township line 2.5' North of the C/L of 10 Mile Road (bit.) running East and West per L.C.R.C. #3983 as set by William Byl in place of a 1" x 36" iron he found in a monument box 103.34' East of the South 1/4 corner of Section 35, T9N, R11W, and 0.21' North of the South line of Section 35 which checked L.C.R.C. #135, the 1949-72 notes of Williams & Works, and the K.C. Surveyor's records.

L.C.R.C. #3983

- Nail & tag, E sd. 18" Boxelder S 10 E 42.24'
- Nail & tag, N sd. 40" Oak N 80 W 110.15'
- Nail & tag, S sd. 18" Oak N 75 E 118.60'
- Nail & tag, W sd. 24" Twin Oak N 10 W 68.12'
- Kent Co. Monument, S 1/4 Cor. Sec. 35, T9N, R10W N 90 W 103.34'


P.A. 345 1990 KENT COUNTY
 PEER APPROVED 6/26/97
 CHAIRMAN Randy Kolehouse

The selected location is accepted by me and is generally accepted by professional surveyors as the best available evidence of the position of the original corner.

C. Description of monument for corner and accessories established to perpetuate locating the position of the corner:

J-1 Standard Kent County Monument in a Monument Box

- Nail & K.C. remon. tag on E side 18" Box Elder S 10° E 42.24'
- Nail & K.C. remon. tag on N side 40" Oak N 80° W 110.15'
- Nail & K.C. remon. tag on S side 18" Oak N 75° E 118.60'
- Nail & K.C. remon. tag on W side 24" Oak N 10° W 68.12'
- K.C. Mon., J-13, T9N, R10W, West 103.34'

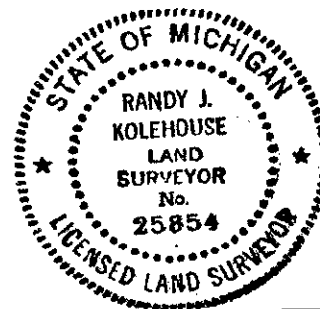

Signed by Randy J. Kolehouse Date 8/12/97

Surveyor's Michigan License No. 25854