

**SURVEY & REMONUMENTATION**  
 \$7.00  
 \$2.00  
 MAR 03 1998

**LAND CORNER RECORDATION CERTIFICATE**  
 Filing Requirement of Act 74, Mich. P.A. 1970  
 KENT COUNTY REMONUMENTATION


For corners in **SECTION**  
Kent  
 (County)

Located in: Cannon Township  
 Corner Code #  
 T 8N R 10W J-2  
 T \_\_\_\_\_ R \_\_\_\_\_  
 T \_\_\_\_\_ R \_\_\_\_\_  
 T \_\_\_\_\_ R \_\_\_\_\_  
 S \_\_\_\_\_ T \_\_\_\_\_ R \_\_\_\_\_  
 S \_\_\_\_\_ T \_\_\_\_\_ R \_\_\_\_\_  
 S \_\_\_\_\_ T \_\_\_\_\_ R \_\_\_\_\_

STATE OF MICHIGAN  
 COUNTY OF KENT  
 RECEIVED FOR RECORD  
 97 DEC 15 AM 10:44  
 REG. OF DEEDS  
*Lucy Standa*

**10408**  
 Register of Deeds Stamp & File Number

- Public Land Survey
- Property Controlling in Section
- Miscellaneous Property in Sec.
- Lot No. \_\_\_\_\_, Recorded Plat \_\_\_\_\_
- Private Claims \_\_\_\_\_

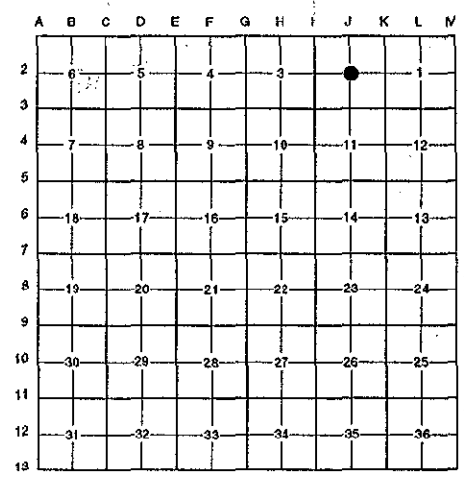

I, Randy Kolehouse, in a field survey on November 4 19 97, do hereby certify that under requirements of P.A. 74 Michigan P.A. of 1970, the corner points mentioned in lines 1 and 2 above were in conformance with regulations and rules therefore as required in the current manual of survey instructions of the United States Department of the interior, Bureau of Land Management or by a decree of a Court of Law and/or that the corner points mentioned in lines 3, 4 and 5 above were in conformance with the rules of the Michigan Board of Land Surveyors or by a Decree of a Court of Law; established, re-established, monumented, re-monumented, recovered, found as expressed below:

**NOTE: Not more than 4 corners, all in the same town and range, may be recorded on this certificate.**

A. Description of original monument and accessories and/or subsequent restoration:

J-2 This corner was not originally set by the G.L.O.  
 Found no additional information on record. Also checked Kent County Surveyor's witness map and found no information pertaining to this corner.

P.A. 345 1990 KENT COUNTY  
 PEER APPROVED 11/20/97  
 CHAIRMAN *[Signature]*


B. Description of corner evidence found and/or method applied in restoring or reestablishing corner:

J-2 Found an "All-Points" iron on line of overhead power lines running East and West. Iron is 0.1' South and 0.2' West of the intersection of 1/4 lines. Accepted iron as Center of Section.

The selected location is accepted by me and is generally accepted by professional surveyors as the best available evidence of the position of the original corner.

C. Description of monument for corner and accessories established to perpetuate locating the position of the corner:

- J-2 Replaced Iron with a Standard Kent County Monument
- Nail & K.C. remon. tag on South side 24' Oak N 55° E 167.27'
  - Nail & K.C. remon. tag on W side of 20' Maple N 20° E 207.42'
  - Nail & K.C. remon. tag on East side 24' Oak N 05° W 183.77'
  - Nail & K.C. remon. tag on West side 10' Cherry S 75° E 64.26'

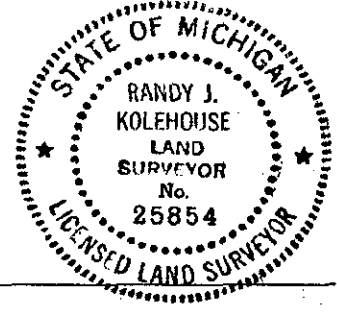

Signed by *Randy J. Kolehouse* Date 11/28/97  
 EARTH TECH

Surveyor's Michigan License No. 25854