

SURVEY & REMONUMENTATION

\$7.00
\$2.00

MAR 03 1998

LAND CORNER RECORDATION CERTIFICATE Filing Requirement of Act 74, Mich. P.A. 1970 KENT COUNTY REMONUMENTATION

For corners in **SECTION**


Kent (County)	Located in: Cannon Township	Corner Code #
1. Public Land Survey	T <u>8N</u> R <u>10W</u>	<u>J-7</u>
	T _____ R _____	_____
	T _____ R _____	_____
	T _____ R _____	_____
2. Property Controlling in Section	S _____ T _____ R _____	_____
	S _____ T _____ R _____	_____
3. Miscellaneous Property in Sec.	S _____ T _____ R _____	_____
	S _____ T _____ R _____	_____

STATE OF MICHIGAN
 COUNTY OF KENT
 RECEIVED FOR RECORD
 97 NOV 14 AM 9:02
 REG. OF DEEDS
Tim Standa

10343
Register of Deeds Stamp & File Number

4. Lot No. _____, Recorded Plat _____
 5. Private Claims _____

I, Randy Kolehouse, in a field survey on August 19 1997, do hereby certify that under requirements of P.A. 74 Michigan P.A. of 1970, the corner points mentioned in lines 1 and 2 above were in conformance with regulations and rules therefore as required in the current manual of survey instructions of the United States Department of the interior, Bureau of Land Management or by a decree of a Court of Law and/or that the corner points mentioned in lines 3, 4 and 5 above were in conformance with the rules of the Michigan Board of Land Surveyors or by a Decree of a Court of Law; established, re-established, monumented, re-monumented, recovered, found as expressed below:

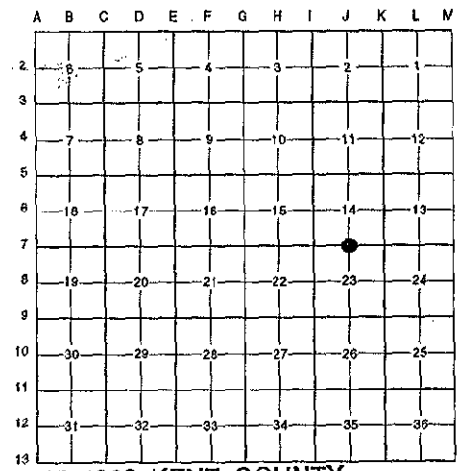

NOTE: Not more than 4 corners, all in the same town and range, may be recorded on this certificate.

A. Description of original monument and accessories and/or subsequent restoration:				
J-7	1831	G.L.O. Notes	Mullett	Set Post
	N/A	Witness Map	K.C. Surveyor	Iron
	1978	L.C.R.C. #1172	Williams & Works	3/4" Iron Pipe
	1981	L.C.R.C. #2439	Jonker Land Surveys	Fnd. 3/4" Iron in Stones / Set K.C. Monument
	1989	L.C.R.C. #5265	J. Bueche	K.C. Monument

P.A. 345 1990 KENT COUNTY
 PEER APPROVED 8/28/97
 CHAIRMAN Harry Huber


This corner was originally approved by the Kent County Remonumentation Peer Group and monumented by Rob Jonker on 12/9/81 and was recorded per L.C.R.C. #2439.

B. Description of corner evidence found and/or method applied in restoring or reestablishing corner:
 J-7 Found a Standard Kent County Monument on North edge of trail running East and West, 2' East of the C/L of trail running North, on line of a tree row running South, and 130' ± East of the C/L of Pickerel Pvt. (bit.) running North and South per L.C.R.C.'s #2439 and #5265 as set by Rob Jonker in place of a 3/4" iron he found in stones which checked L.C.R.C. #1172 and the K.C. Surveyor's records.

L.C.R.C. #2439	L.C.R.C. #5265
Remon. tag on S side 24" Oak S78°E 28.17'	Remon. tag & nail on S side 28" Oak S 78° E 28.17'
Remon. tag on W side 18" Hickory S06°E 35.83'	Remon. tag & nail on W side 22" Hickory S 06° E 35.87'
Remon. tag on E side 16" Hickory N03°E 9.36'	Remon. tag & nail on E side 18" Hickory N 03° E 9.36' (m. 9.36')
Remon. tag on NE side 8" W. Cherry N60°W 33.82'	Remon. tag & nail on NE side 10" W. Cherry N 60° W 33.82'
Remon. tag on NW side 6" Oak S66°W 54.35'	Remon. tag & nail on NW side 10" Oak S 66° W 54.39'

The selected location is accepted by me and is generally accepted by professional surveyors as the best available evidence of the position of the original corner.

C. Description of monument for corner and accessories established to perpetuate locating the position of the corner:
 J-7 Standard Kent County Monument
 Nail & K.C. remon. tag on S side 28" Oak S 78° E 28.17'
 Nail & K.C. remon. tag on W side 22" Hickory S 06° E 35.87'
 Nail & K.C. remon. tag on E side 18" Hickory N 03° E 9.36'
 Nail & K.C. remon. tag on NE side 8" W. Cherry N 60° W 33.82'

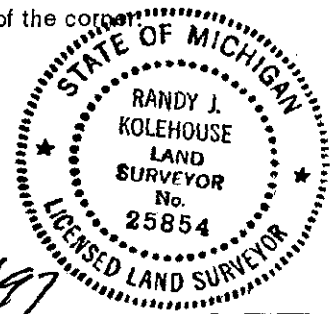

Signed by Randy J. Kolehouse Date 9/23/97
 EARTH TECH
 Surveyor's Michigan License No. 25854