

MAR 03 1998

SECTION

LAND CORNER RECORDATION CERTIFICATE
Filing Requirement of Act 74, Mich. P.A. 1970
KENT COUNTY REMONUMENTATION

For corners in

Table with columns: Kent (County), Located in: Cannon Township, Corner Code #. Rows include Public Land Survey, Property Controlling in Section, and Miscellaneous Property in Sec.

STATE OF MICHIGAN
COUNTY OF KENT
RECEIVED FOR RECORD
97 OCT 15 AM 8:47
REG. OF DEEDS

10138

Register of Deeds Stamp & File Number


4. Lot No. _____, Recorded Plat _____
5. Private Claims _____

I, Randy Kolehouse, in a field survey on June 25 19 97, do hereby certify that under requirements of P.A. 74 Michigan P.A. of 1970, the corner points mentioned in lines 1 and 2 above were in conformance with regulations and rules therefore as required in the current manual of survey instructions of the United States Department of the interior, Bureau of Land Management or by a decree of a Court of Law and/or that the corner points mentioned in lines 3, 4 and 5 above were in conformance with the rules of the Michigan Board of Land Surveyors or by a Decree of a Court of Law; established, re-established, monumented, re-monumented, recovered, found as expressed below:

NOTE: Not more than 4 corners, all in the same town and range, may be recorded on this certificate.

A. Description of original monument and accessories and/or subsequent restoration:

Table with columns: J-9, 1831, 1943, 1974, 1977, 1981, 1989, G.L.O. Notes, Witness Map, L.C.R.C. #685, L.C.R.C. #1050, L.C.R.C. #2440, L.C.R.C. #5266, Mullett, K.C. Surveyor, Exxel Engineering, Williams & Works, Jonker Land Surveys, J. Bueche, Set Post, 1" Pipe, 3/4" Iron, 1" Pipe, Fnd. "T" Iron / Set K.C. Monument, K.C. Monument

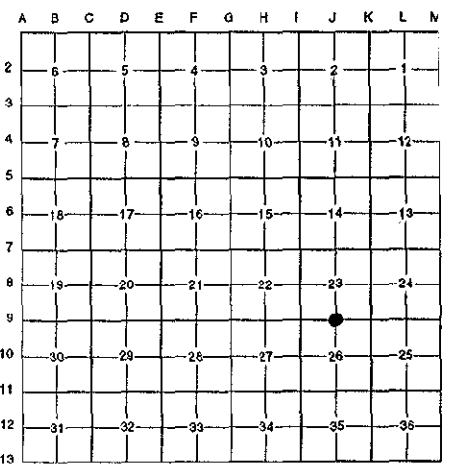

This corner was originally approved by the Kent County Remonumentation Peer Group and monumented by Rob Jonker on 12/8/81 and was recorded per L.C.R.C. #2440.

B. Description of corner evidence found and/or method applied in restoring or reestablishing corner:

J-9 Found a Standard Kent County Monument 7' ± North of the C/L of 6 Mile Road (bit.) running East and West, on East edge of gravel parking lot of Townsend Park on the North side of 6 Mile Road, per L.C.R.C.'s #2440 and #5266 as set by Rob Jonker in place of "T" iron he found at grade on a 3/4" iron 18" below grade which checked L.C.R.C.'s #1050, #650, and the K.C. Surveyor's records.

L.C.R.C. #2440

- Remon. tag on W side t&p pole N15°E 25.13'
Remon. tag on NE side 10" Pine S39°E 47.96'
Remon. tag on E side 10" Pine S15°W 44.69'
Remon. tag on N side 24" Poplar S72°W 119.21'
S. edge speed limit sign post, N.4.4'

L.C.R.C. #5266


- Remon. tag & nail on W side t & p pole N 15° E 25.13'
Remon. tag & nail on NE side 14" Pine S 39° E 47.96'
Remon. tag & nail on E side 14" Pine S 15° W 44.80'
Remon. tag & nail on N side 28" Poplar S 72° W 118.75'
S. edge speed limit sign post N 4.4'

The selected location is accepted by me and is generally accepted by professional surveyors as the best available evidence of the position of the original corner.

C. Description of monument for corner and accessories established to perpetuate locating the position of the corner:

J-9 Standard Kent County Monument
Nail & K.C. remon. tag on W side T. & P. pole N 15° E 25.13'
Nail & K.C. remon. tag on NE side 14" Pine S 39° E 47.96'
Nail & K.C. remon. tag on E side 14" Pine S 15° W 44.80'
Nail & K.C. remon. tag on N side 28" Poplar S 72° W 118.75'

P.A. 345 1990 KENT COUNTY
PEER APPROVED 7/24/97
CHAIRMAN

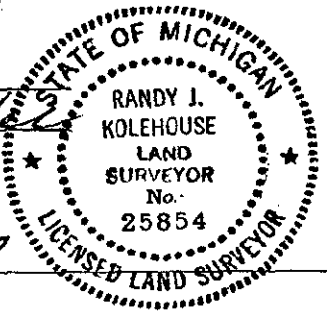

Signed by Randy J. Kolehouse
EARTH TECH

Date 8/12/97

Surveyor's Michigan License No. 25854