

MAR 03 1998

SECTION

LAND CORNER RECORDATION CERTIFICATE
Filing Requirement of Act 74, Mich. P.A. 1970
KENT COUNTY REMONUMENTATION

For corners in

Kent
(County)

Located in: Cannon Township

Corner Code #

- 1. Public Land Survey
T 8N R 10W J-11
T _____ R _____
T _____ R _____
T _____ R _____
- 2. Property Controlling in Section
S _____ T _____ R _____
S _____ T _____ R _____
- 3. Miscellaneous Property in Sec.
S _____ T _____ R _____
S _____ T _____ R _____

- 4. Lot No. _____, Recorded Plat _____
- 5. Private Claims _____

STATE OF MICHIGAN
COUNTY OF KENT
RECEIVED FOR RECORD
97 OCT 15 AM 8:47
REG. OF DEEDS
Luci Standa

10139

Register of Deeds Stamp & File Number

I, Randy Kolehouse, in a field survey on June 30 19 97, do hereby certify that under requirements of P.A. 74 Michigan P.A. of 1970, the corner points mentioned in lines 1 and 2 above were in conformance with regulations and rules therefore as required in the current manual of survey instructions of the United States Department of the interior, Bureau of Land Management or by a decree of a Court of Law and/or that the corner points mentioned in lines 3, 4 and 5 above were in conformance with the rules of the Michigan Board of Land Surveyors or by a Decree of a Court of Law; established, re-established, monumented, re-monumented, recovered, found as expressed below:

NOTE: Not more than 4 corners, all in the same town and range, may be recorded on this certificate.

A. Description of original monument and accessories and/or subsequent restoration:

J-11	1831	G.L.O. Notes	Mullett	Set Post
	1946	Witness Map	K.C. Surveyor	Monument
	1973	L.C.R.C. #595	Exxel Engineering	"T" Iron
	1981	L.C.R.C. #2441	Jonker Land Surveys	Fnd. "T" Iron & Conc. Mon. / Set K.C. Monument
	1989	L.C.R.C. #5267	J. Bueche	K.C. Monument

This corner was originally approved by the Kent County Remonumentation Peer Group and monumented by Rob Jonker on 12/9/81 and was recorded per L.C.R.C. #2441.

B. Description of corner evidence found and/or method applied in restoring or reestablishing corner:

J-11 Found a Standard Kent County Monument on 2.5' North of the C/L of 5 Mile Road (bit.) running East and West and 3' West of a fence line running North per L.C.R.C.'s #2441 and #5267 as set by Rob Jonker in place of a "T" iron he found at grade in top of a 4" x 36" concrete monument 12" below grade which checked L.C.R.C. #595 and the K.C. Surveyor's records.

L.C.R.C. #2441

Remon. tag on W side 10" Locust N 31.70'
W. end of N rerod at W end H/W S 72° E 102.57'
NW corner concrete H/W N 77° E 102.61'
Remon. tag on SE side 9" Locust N 54° E 40.52'
Remon. tag on S side 36" Maple N 70° W 81.50'

L.C.R.C. #5267

Remon. tag & nail on W side 10" Locust N 31.70'
W end of N rerod at W end H/W S 72° E 102.57'
NW corner concrete H/W N 77° E 102.61'
Remon. tag & nail on SE side 12" Locust N 54° E 40.55'
Remon. tag & nail on S side 42" Maple N 70° W 81.35'
Remon. tag & nail on N side 12" Elm S 25° W 28.47'

The selected location is accepted by me and is generally accepted by professional surveyors as the best available evidence of the position of the original corner.

C. Description of monument for corner and accessories established to perpetuate locating the position of the corner:


J-11 Standard Kent County Monument

Nail & K.C. remon. tag on W side 12" Locust North 31.70'
W end of N rerod at W end H/W S 72° E 102.57'
NW cor conc. headwall N 77° E 102.61'
Nail & K.C. remon. tag on SE side 12" Locust N 54° E 40.55'
Nail & K.C. remon. tag on S side 42" Maple N 20° W 81.35'

P.A. 345 1990 KENT COUNTY

PEER APPROVED 7/28/97

CHAIRMAN *Henry Huber*

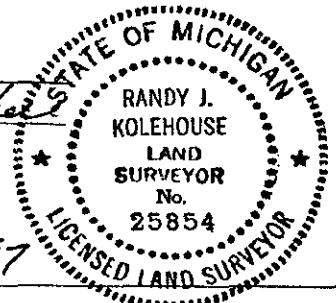

Signed by *Randy J. Kolehouse* Date 8/12/97

EARTH TECH

Surveyor's Michigan License No. 25854