

SURVEY & REMONUMENTATION

MAR 03 1998

SECTION

LAND CORNER RECORDATION CERTIFICATE
Filing Requirement of Act 74, Mich. P.A. 1970
KENT COUNTY REMONUMENTATION

For corners in

<u>Kent</u> (County)	Located in: Cannon Township	Corner Code #
1. Public Land Survey	T <u>8N</u> R <u>10W</u>	<u>J-13</u>
	T _____ R _____	_____
	T _____ R _____	_____
	T _____ R _____	_____
2. Property Controlling in Section	S _____ T _____ R _____	_____
	S _____ T _____ R _____	_____
3. Miscellaneous Property in Sec.	S _____ T _____ R _____	_____
	S _____ T _____ R _____	_____


STATE OF MICHIGAN
 COUNTY OF KENT
 RECEIVED FOR RECORD
 97 OCT 15 AM 8:47
 REG. OF DEEDS
Lucy Grand

10140

Register of Deeds Stamp & File Number

4. Lot No. _____, Recorded Plat _____
 5. Private Claims _____

I, Randy Kolehouse, in a field survey on June 30 19 97, do hereby certify that under requirements of P.A. 74 Michigan P.A. of 1970, the corner points mentioned in lines 1 and 2 above were in conformance with regulations and rules therefore as required in the current manual of survey instructions of the United States Department of the interior, Bureau of Land Management or by a decree of a Court of Law and/or that the corner points mentioned in lines 3, 4 and 5 above were in conformance with the rules of the Michigan Board of Land Surveyors or by a Decree of a Court of Law; established, re-established, monumented, re-monumented, recovered, found as expressed below:

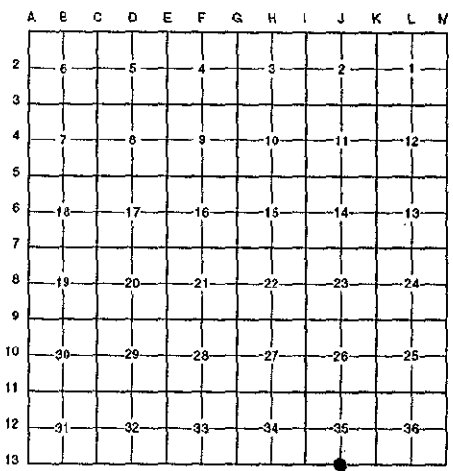

NOTE: Not more than 4 corners, all in the same town and range, may be recorded on this certificate.

A. Description of original monument and accessories and/or subsequent restoration:

J-13	1831	G.L.O. Notes	Mullett	Set Post	P.A. 345 1990 KENT COUNTY
	1968	Witness Map	K.C. Surveyor	Stake & Stone	PEER APPROVED <u>7/24/97</u>
	1968	Notes	Williams & Works	"T" Iron	CHAIRMAN <u>Harry Huber</u>
	1978	Notes	Moore & Bruggink	"T" Iron	
	1984	L.C.R.C. #3962	Exxel Engineering	Fnd. "T" Iron / Set K.C. Monument	
	1989	L.C.R.C. #5268	J. Bueche	K.C. Monument	

Note: This corner is not common with J-1, T7N, R10W.

This corner was originally approved by the Kent County Remonumentation Peer Group and monumented by Exxel Engineering on 9/7/84 and was recorded per L.C.R.C. #3962.

B. Description of corner evidence found and/or method applied in restoring or reestablishing corner:

J-13 Found a Standard Kent County Monument (broken) 3' North of the C/L of 4 Mile Road (gravel) running East and West per L.C.R.C.'s #3962 and #5268 as set Exxel Engineering in place of a "T" Iron they found which checked the 1968 notes of Williams & Works, the 1978 notes of Moore & Bruggink, and the K.C. Surveyor's records.

L.C.R.C. #3962

- Nail & remon tag in S sde 15" Maple N81°E 120.57'
- Nail & remon tag in N sde 6" Maple S66°E 51.20'
- Nail & remon tag in N sde 4" W. Cherry S70°W 59.07'
- N 1/4 corner, Section 2, T7N, R10W (C.L. Mon.) West 164.47'

L.C.R.C. #5268


- Nail & remon tag in S side 18" Maple N 81° E 120.57'
- Nail & remon tag in N side 8" Maple S 66° E 51.20'
- Nail & remon tag in N side 6" W. Cherry S 70° W 59.07'
- Nail & remon tag in N side 8" W. Cherry S 30° E 25.15'
- K.C. Mon. N 1/4 corner, Section 2, T7N, R10W, West 164.47'

The selected location is accepted by me and is generally accepted by professional surveyors as the best available evidence of the position of the original corner.

C. Description of monument for corner and accessories established to perpetuate locating the position of the corner:

J-13 Reset a Standard Kent County Monument

- Nail & K.C. remon. tag on S side 18" Maple N 81° E 120.57'
- Nail & K.C. remon. tag on N side 10" Maple S 66° E 51.20'
- Nail & K.C. remon. tag on N side 6" W. Cherry S 70° W 59.07'
- Nail & K.C. remon. tag on N side 8" Cherry S 30° E 25.15'
- K.C. Mon., J-1, T7N, R10W, West 164.47'

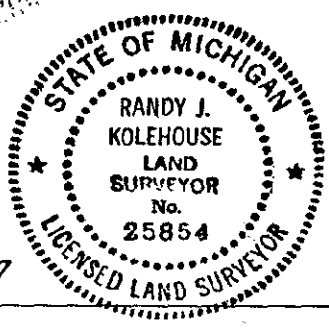

Signed by Randy J. Kolehouse
 EARTH TECH

Date 8/12/97

Surveyor's Michigan License No. 25854