

MAR 03 1998

SECTION

LAND CORNER RECORDATION CERTIFICATE
Filing Requirement of Act 74, Mich. P.A. 1970
KENT COUNTY REMONUMENTATION

For corners in

| Kent (County) | Located in: Cannon Township | Corner Code # |
|---------------------------------------|--------------------------------|---------------|
| 1. Public Land Survey | T <u>8N</u> R <u>10W</u> | <u>K-1</u> |
| | T _____ R _____ | _____ |
| | T _____ R _____ | _____ |
| | T _____ R _____ | _____ |
| 2. Property Controlling in Section | S _____ T _____ R _____ | _____ |
| | S _____ T _____ R _____ | _____ |
| 3. Miscellaneous Property in Sec. | S _____ T _____ R _____ | _____ |
| | S _____ T _____ R _____ | _____ |

STATE OF MICHIGAN
 COUNTY OF KENT
 RECEIVED FOR RECORD
 97 OCT 15 AM 8:47
 REG. OF DEEDS
Lucy Starnel

10141

Register of Deeds Stamp & File Number

4. Lot No. _____, Recorded Plat _____
 5. Private Claims _____

| | | | | | | | | | | | | |
|----|----|----|----|----|----|----|---|---|---|---|---|---|
| A | B | C | D | E | F | G | H | I | J | K | L | M |
| 2 | 6 | 5 | 4 | 3 | 2 | 1 | | | | | | |
| 3 | | | | | | | | | | | | |
| 4 | 7 | 8 | 9 | 10 | 11 | 12 | | | | | | |
| 5 | | | | | | | | | | | | |
| 6 | 18 | 17 | 16 | 15 | 14 | 13 | | | | | | |
| 7 | | | | | | | | | | | | |
| 8 | 19 | 20 | 21 | 22 | 23 | 24 | | | | | | |
| 9 | | | | | | | | | | | | |
| 10 | 30 | 29 | 28 | 27 | 26 | 25 | | | | | | |
| 11 | | | | | | | | | | | | |
| 12 | 31 | 32 | 33 | 34 | 35 | 36 | | | | | | |
| 13 | | | | | | | | | | | | |

I, Randy Kolehouse, in a field survey on June 24 19 97, do hereby certify that under requirements of P.A. 74 Michigan P.A. of 1970, the corner points mentioned in lines 1 and 2 above were in conformance with regulations and rules therefore as required in the current manual of survey instructions of the United States Department of the Interior, Bureau of Land Management or by a decree of a Court of Law and/or that the corner points mentioned in lines 3, 4 and 5 above were in conformance with the rules of the Michigan Board of Land Surveyors or by a Decree of a Court of Law; established, re-established, monumented, re-monumented, recovered, found as expressed below:

NOTE: Not more than 4 corners, all in the same town and range, may be recorded on this certificate.

A. Description of original monument and accessories and/or subsequent restoration:

| K-1 | 1831 | G.L.O. Notes | Mullett | Set Post |
|-----|-----------|----------------|------------------|----------------------------------|
| | 1961 | Witness Map | K.C. Surveyor | Iron & Monument Box |
| | 1888-1972 | Notes | Williams & Works | Iron |
| | 1972 | L.C.R.C. #135 | Williams & Works | 3/4" Iron in Monument Box |
| | 1984 | L.C.R.C. #3984 | William Byl | Fnd. 1" Iron / Set K.C. Monument |
| | 1992 | L.C.R.C. #6237 | Chris Marschall | K.C. Monument |

Note: This corner is not common with K-13, T9N, R10W.

This corner was originally approved by the Kent County Remonumentation Peer Group and monumented by William Byl on 10/16/84 and was recorded per L.C.R.C. #3984.

B. Description of corner evidence found and/or method applied in restoring or reestablishing corner:

K-1 Found a Standard Kent County Monument on the C/L of 10 Mile Road (bit.) running East and West and 4' ± East of a tree row running to the South per L.C.R.C.'s #3984 and #6237 as set by William Byl in place of a 1" iron he found over a 1" pipe in a monument box 92.27' East of a K.C. Monument Monument at the SE corner of Section 35 and 0.05' North of the South line of Section 36, T9N, R10W. Checked L.C.R.C. #135, the 1888 through 1972 notes of Williams & Works, and the K.C. Surveyor's records.

L.C.R.C. #3984

Nail & tag, E sd. 24" Oak S 05 E 64.22'
 NE cor. fnd. House #8800 S 35 W 141.04'
 NE cor. top of stone wall S 15 W 80.81'
 SW cor. fnd. House #8831 N 60 E 150.87'

L.C.R.C. #6237

Mon. K-13 9N 10W N 90 W 92.38'
 Nail & Tag E sd. 32" Oak S 08 E 64.12'
 NE cor. top stone wall 1.5 x 22 S 10 W 80.80'
 NW cor. Hse. fnd. #8800 S 41 W 161.12'
 Nail & Tag S sd. U.P. N 57 E 119.59'
 Nail & Tag W sd. bird hse. pole N 20 E 108.44'


The selected location is accepted by me and is generally accepted by professional surveyors as the best available evidence of the position of the original corner.

C. Description of monument for corner and accessories established to perpetuate locating the position of the corner:

K-1 Standard Kent County Monument
 Nail & K.C. remon. tag on E side 32" Oak S -08° E 64.12'
 NE cor. top stone wall 1.5' x 22' S 10° W 80.80'
 NW cor. hse. fndn. #8800 S 41° W 161.12'
 Nail & K.C. remon. tag on S side U. pole N 57° E 119.59'
 K.C. Mon., K-13, T9N, R10W, West 92.38'

P.A. 345 1990 KENT COUNTY

PEER APPROVED 6/26/97
 (CHAIRMAN Frank Kube)

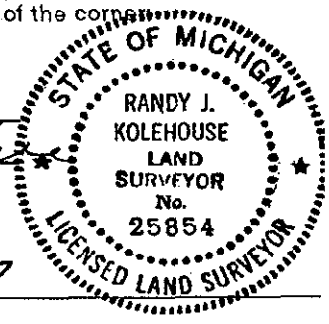

Signed by Randy J. Kolehouse Date 8/12/97

Surveyor's Michigan License No. 25854