

SURVEY & REMONUMENTATION

MAR 03 1998

LAND CORNER RECORDATION CERTIFICATE Filing Requirement of Act 74, Mich. P.A. 1970 KENT COUNTY REMONUMENTATION

For corners in

Kent SECTION (County)	Located in: Cannon Township	Corner Code #
1. Public Land Survey	T <u>8N</u> R <u>10W</u>	<u>K-4</u>
	T _____ R _____	_____
	T _____ R _____	_____
	T _____ R _____	_____
2. Property Controlling in Section	S _____ T _____ R _____	_____
	S _____ T _____ R _____	_____
3. Miscellaneous Property in Sec.	S _____ T _____ R _____	_____
	S _____ T _____ R _____	_____

REG. OF DEEDS

L. J. Bueche

97 OCT 15 AM 8:47

STATE OF MICHIGAN
COUNTY OF KENT
REGISTERED FOR RECORD

10144

Register of Deeds Stamp & File Number

4. Lot No. _____, Recorded Plat _____
5. Private Claims _____

I, Randy Kolehouse, in a field survey on June 25 19 97, do hereby certify that under requirements of P.A. 74 Michigan P.A. of 1970, the corner points mentioned in lines 1 and 2 above were in conformance with regulations and rules therefore as required in the current manual of survey instructions of the United States Department of the interior, Bureau of Land Management or by a decree of a Court of Law and/or that the corner points mentioned in lines 3, 4 and 5 above were in conformance with the rules of the Michigan Board of Land Surveyors or by a Decree of a Court of Law; established, re-established, monumented, re-monumented, recovered, found as expressed below:

NOTE: Not more than 4 corners, all in the same town and range, may be recorded on this certificate.

A. Description of original monument and accessories and/or subsequent restoration:

K-4	1831 G.L.O. Notes	Mullett	Set Post
	1962 Survey Records	Williams & Works	"T" Iron
	1983 L.C.R.C. #3491	J. Bueche	Fnd. "T" Iron / Set K.C. Monument
	1989 L.C.R.C. #5271	J. Bueche	K.C. Monument

P.A. 345 1990 KENT COUNTY
PEER APPROVED 7/29/97
CHAIRMAN [Signature]

This corner was originally approved by the Kent County Remonumentation Peer Group and monumented by J. Bueche on 6/27/83 and was recorded per L.C.R.C. #3491.

B. Description of corner evidence found and/or method applied in restoring or reestablishing corner:

K-4 Found a Standard Kent County Monument 2' East of the C/L of Ramsdell Drive (bit.) running North and South per L.C.R.C.'s #3491 and #5271 as set by J. Bueche in place of a "T" iron he found which checked the 1962 survey records of Williams & Works.

L.C.R.C. #3491

- Cut nail in N. side 30" Maple N 65° E 25.05'
- Cut nail in SE'ly side 20" Hickory S 65° W 32.58'
- Cut nail in N side 26" Oak S 50° E 30.20'
- NE cor. conc. headwall E side of road N 15° E 60.29'

L.C.R.C. #5271


- Cut nail in N side 32" Maple N 65° E 25.05'
- Remon. tag & nail in Se'ly side 22" Hickory S 65° W 32.65'
- Remon. tag & nail in N side 28" Oak S 50° E 30.27'
- NE cor. conc. headwall E side of road N 15° E 60.29'

The selected location is accepted by me and is generally accepted by professional surveyors as the best available evidence of the position of the original corner.

C. Description of monument for corner and accessories established to perpetuate locating the position of the corner:

K-4 Standard Kent County Monument

- Nail & K.C. remon. tag on N side 32" Maple N 65° E 25.05'
- Nail & K.C. remon. tag on SE'ly side 22" Sassafras S 65° W 32.65'
- Nail & K.C. remon. tag on N side 28" Oak S 50° E 30.27'
- NE corner conc. headwall E side road N 15° E 60.29'

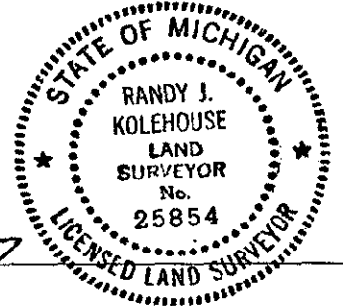

Signed by [Signature] Date 9/12/97
EARTH TECH

Surveyor's Michigan License No. 25854