

SURVEY & REMONUMENTATION

MAR 03 1998

SECTION

LAND CORNER RECORDATION CERTIFICATE
Filing Requirement of Act 74, Mich. P.A. 1970
KENT COUNTY REMONUMENTATION

For corners in

<u>Kent</u> (County)	Located in: Cannon Township	Corner Code #
1. Public Land Survey	T <u>8N</u> R <u>10W</u>	<u>K-11</u>
	T _____ R _____	_____
	T _____ R _____	_____
	T _____ R _____	_____
2. Property Controlling in Section	S _____ T _____ R _____	_____
	S _____ T _____ R _____	_____
3. Miscellaneous Property in Sec.	S _____ T _____ R _____	_____
	S _____ T _____ R _____	_____

REG. OF DEEDS

Luci Standa

97 OCT 15 AM 8:48


STATE OF MICHIGAN
 COUNTY OF KENT
 RECEIVED FOR RECORD

10149

Register of Deeds Stamp & File Number

4. Lot No. _____, Recorded Plat _____
 5. Private Claims _____

I, Randy Kolehouse, in a field survey on June 26 19 97, do hereby certify that under requirements of P.A. 74 Michigan P.A. of 1970, the corner points mentioned in lines 1 and 2 above were in conformance with regulations and rules therefore as required in the current manual of survey instructions of the United States Department of the interior, Bureau of Land Management or by a decree of a Court of Law and/or that the corner points mentioned in lines 3, 4 and 5 above were in conformance with the rules of the Michigan Board of Land Surveyors or by a Decree of a Court of Law; established, re-established, monumented, re-monumented, recovered, found as expressed below:

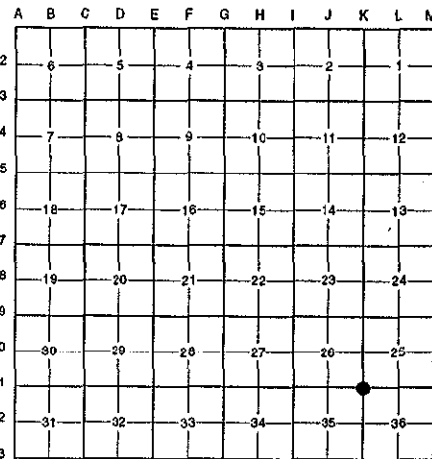

NOTE: Not more than 4 corners, all in the same town and range, may be recorded on this certificate.

A. Description of original monument and accessories and/or subsequent restoration:

K-11	1831	G.L.O. Notes	Mullett	Set Post
	1893	Notes	Williams & Works	Large Stone
	1963	Witness Map	K.C. Surveyor	Boat Spike
	1987	L.C.R.C. #4488	All-Points Surveyors	Fnd. 3/4" Iron in Mon. Box / Set K.C. Monument
	1989	L.C.R.C. #5278	J. Bueche	K.C. Monument in Monument Box

This corner was originally approved by the Kent County Remonumentation Peer Group and monumented by All-Points Surveyors in January of 1987 and was recorded per L.C.R.C. #4488.

B. Description of corner evidence found and/or method applied in restoring or reestablishing corner:

K-11 Found a Standard Kent County Monument on the C/L of Giles Road (bit.) running North and South and 75' South of the C/L of 5 Mile Road running East and West per L.C.R.C.'s #4488 and #5278 as set by All-Points Surveyors in place of a 3/4" iron they found in a monument which checked the K.C. Surveyor's records.

L.C.R.C. #4488

L.C.R.C. #5278

Nail & K.C. Remon Tag SW side MBT pole N 45° W 49.72'
 Nail & K.C. Remon. Tag N side 32" Walnut S 50° W 64.60'
 Nail & K.C. Remon Tag N side P. Pole N 55° E 46.93'


Nail & remon tag in SW side MBT pole N 45° W 49.72'
 Nail & remon tag N side 34" Walnut S 50° W 64.60'
 Nail & remon tag in N side p pole N 55° E 46.37'

The selected location is accepted by me and is generally accepted by professional surveyors as the best available evidence of the position of the original corner.

C. Description of monument for corner and accessories established to perpetuate locating the position of the corner:

K-11 Standard Kent County Monument

Nail & K.C. remon. tag on N side Guy pole S 55° E 48.30'
 Nail & K.C. remon. tag on SW side MBT pole N 45° W 49.72'
 Nail & K.C. remon. tag on N side 34" Walnut S 50° W 64.60'
 Nail & K.C. remon. tag on N side P. pole N 55° E 46.37'

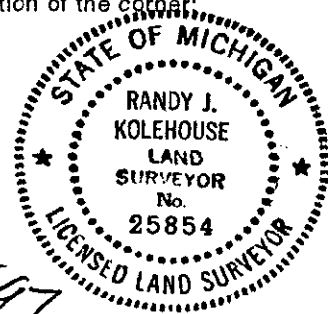

Signed by *Randy J. Kolehouse* Date 8/10/97
 (EARTH TECH)

Surveyor's Michigan License No. 25854

P.A. 345 1990 KENT COUNTY
 PEER APPROVED 7/24/97
 CHAIRMAN *Frank Huber*