

SURVEY & REMONUMENTATION

MAR 03 1998

SECTION

LAND CORNER RECORDATION CERTIFICATE
Filing Requirement of Act 74, Mich. P.A. 1970
KENT COUNTY REMONUMENTATION

For corners in.

<u>Kent</u> (County)	Located in: Cannon Township	Corner Code #	
1. Public Land Survey	T <u>8N</u> R <u>10W</u>	<u>L-1</u>	
	T _____ R _____	_____	_____
	T _____ R _____	_____	_____
	T _____ R _____	_____	_____
2. Property Controlling in Section	S _____ T _____ R _____	_____	_____
	S _____ T _____ R _____	_____	_____
3. Miscellaneous Property in Sec.	S _____ T _____ R _____	_____	_____
	S _____ T _____ R _____	_____	_____
4. Lot No. _____, Recorded Plat _____			
5. Private Claims _____			

STATE OF MICHIGAN
 COUNTY OF KENT
 RECEIVED FOR RECORD
 97 OCT 15 AM 8:48
 REG. OF DEEDS
[Signature]

10152

Register of Deeds Stamp & File Number

I, Randy Kolehouse, in a field survey on July 1 19 97, do hereby certify that under requirements of P.A. 74 Michigan P.A. of 1970, the corner points mentioned in lines 1 and 2 above were in conformance with regulations and rules therefore as required in the current manual of survey instructions of the United States Department of the interior, Bureau of Land Management or by a decree of a Court of Law and/or that the corner points mentioned in lines 3, 4 and 5 above were in conformance with the rules of the Michigan Board of Land Surveyors or by a Decree of a Court of Law; established, re-established, monumented, re-monumented, recovered, found as expressed below:

NOTE: Not more than 4 corners, all in the same town and range, may be recorded on this certificate.

A. Description of original monument and accessories and/or subsequent restoration:

L-1	This corner was not originally set by the G.L.O.		
N/A	Witness Map	K.C. Surveyor	Iron
1979	L.C.R.C. #1295	Exxel Engineering	Spine in Mon. Box
1984	L.C.R.C. #3985	William Byl	Fnd. 1" Iron in Mon. Box / Set K.C. Monument
1991	L.C.R.C. #6226	Chris Marschall	K.C. Monument

Note: This corner is not common with L-13, T9N, R10W.

This corner was originally approved by the Kent County Remonumentation Peer Group and monumented by William Byl on 10/16/84 and was recorded per L.C.R.C. #3985.

B. Description of corner evidence found and/or method applied in restoring or reestablishing corner:

L-1 Found a Standard Kent County Monument on the Township line on the C/L of 10 Mile Road (bit.) running East and West and 50' ± East of the C/L of Ramsdell Road (bit.) running North and South per L.C.R.C.'s #3985 and #6226 as set by William Byl in place of a 1" iron he found in a monument box 29.21' East of a Kent County Monument at the S 1/4 corner of Section 36, T9N, R10W, and 0.08' North of the South line of Section 36 which checked L.C.R.C. #1295 and the K.C. Surveyor's records.

L.C.R.C. #3985

L.C.R.C. #6226

Nail & tag, S sd. 36" Oak N 80 E 97.80'
 Nail & tag, W sd. 36" Oak N 10 W 66.68'
 SW cor. stone house fndn. N 40 E 140.92'
 Nail & tag, E sd. 24" Oak S 30 W 79.40'
 Concrete monument S 00 W 33.03'


Nail & Remon tag in W sd. 24" Oak S 33 W 79.19' (m. 79.42')
 Nail & Remon tag in W sd. 22" Maple S 03° E 36.54'
 Nail & Remon tag in S sd. 38" Oak N 77 E 97.74'
 Nail & Remon tag in W sd. 36" Oak N 10 W 66.67' (m. 66.45')
 K.C. Remon L-13 T9N R10W West 29.22'

The selected location is accepted by me and is generally accepted by professional surveyors as the best available evidence of the position of the original corner.

C. Description of monument for corner and accessories established to perpetuate locating the position of the corner:

L-1 Standard Kent County Monument
 Nail & K.C. remon. tag on W side 24" Oak S 33° W 79.42'
 Nail & K.C. remon. tag on W side 22" Maple S 03° E 36.54'
 Nail & K.C. remon. tag on S side 38" Oak N 77° E 97.74'
 Nail & K.C. remon. tag on W side 36" Oak N 10 W 66.45'
 K.C. Mon., L-13, T9N, R10W, West 29.22'

P.A. 345 1990 KENT COUNTY
 PEER APPROVED 7/24/97
 CHAIRMAN *[Signature]*

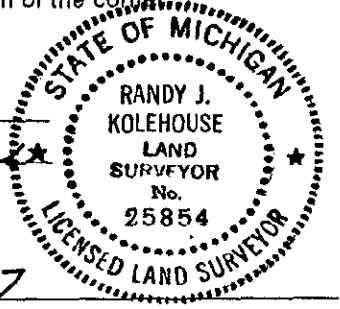

Signed by Randy J. Kolehouse Date 9/12/97
 EARTH TECH

Surveyor's Michigan License No. 25854

