

SURVEY & REMONUMENTATION

\$7.00 MAR 03 1998
\$2.00

SECTION

For corners in

Kent
(County)

Located in: Cannon Township

Corner Code #

- | | | | | | |
|------------------------------------|---|-----------|---|------------|------------|
| 1. Public Land Survey | T | <u>8N</u> | R | <u>10W</u> | <u>L-3</u> |
| | T | | R | | |
| | T | | R | | |
| | T | | R | | |
| 2. Property Controlling in Section | S | | T | | |
| | S | | T | | |
| 3. Miscellaneous Property in Sec. | S | | T | | |
| | S | | T | | |

4. Lot No. _____, Recorded Plat _____
5. Private Claims _____

LAND CORNER RECORDATION CERTIFICATE
Filing Requirement of Act 74, Mich. P.A. 1970
KENT COUNTY REMONUMENTATION

STATE OF MICHIGAN
COUNTY OF KENT
RECEIVED FOR RECORD
97 DEC 15 AM 10:45
REG. OF DEEDS
Lucy Stoddard

10415

Register of Deeds Stamp & File Number


I, Randy Kolehouse, in a field survey on November 7 19 97, do hereby certify that under requirements of P.A. 74 Michigan P.A. of 1970, the corner points mentioned in lines 1 and 2 above were in conformance with regulations and rules therefore as required in the current manual of survey instructions of the United States Department of the Interior, Bureau of Land Management or by a decree of a Court of Law and/or that the corner points mentioned in lines 3, 4 and 5 above were in conformance with the rules of the Michigan Board of Land Surveyors or by a Decree of a Court of Law; established, re-established, monumented, re-monumented, recovered, found as expressed below:

NOTE: Not more than 4 corners, all in the same town and range, may be recorded on this certificate.

A. Description of original monument and accessories and/or subsequent restoration:

L-3	1831	G.L.O. Notes	Mullett	Set Post
	1983	L.C.R.C. #3447	G. Fauser	3/4" Pipe
	1985	L.C.R.C. #4227	J. Bueche	Fnd. 1" Iron / Set K.C. Monument
	1989	L.C.R.C. #5281	J. Bueche	K.C. Monument

P.A. 345 1990 KENT COUNTY
PEER APPROVED 11/30/97
CHAIRMAN *Harry Hubers*

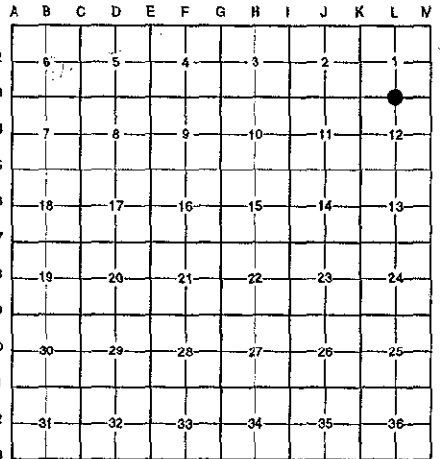

This corner was originally approved by the Kent County Remonumentation Peer Group and monumented by J. Bueche on 4/15/85 and was recorded per L.C.R.C. #4227.

B. Description of corner evidence found and/or method applied in restoring or reestablishing corner:

L-3 Found a Standard Kent County Monument on line of an old fence line running North and West at the NE edge of a swamp per L.C.R.C.'s #4227 and #5281 as set by J. Bueche in place of a 1" iron he found which checked L.C.R.C. #3447.

L.C.R.C. #4227	L.C.R.C. #5281
K.C. Remon. tag & nail in W. side 4" Poplar N 10° E 89.15'	Remon. tag & nail in W side 6" Poplar N 10° E 89.15' (m. 89.12')
K.C. Remon. tag & nail in NE side 3" Elm S 45° E 39.63'	Remon. tag & nail in NE side 6" Elm S 45° E 39.63'
Mon. @ fence cor. fence West & North	Mon. @ fence cor. fence West & North
	Remon. tag & nail in SE side 4" Tree N 50° E 19.23'

The selected location is accepted by me and is generally accepted by professional surveyors as the best available evidence of the position of the original corner.

C. Description of monument for corner and accessories established to perpetuate locating the position of the corner:

- L-3 Standard Kent County Monument
- Nail & K.C. remon. tag on W face 6" Poplar N 10° E 89.12'
 - Nail & K.C. remon. tag on NE face 6" Elm S 45° E 39.63'
 - Nail & K.C. remon. tag on SE face 4" Elm N 50° E 19.23'
 - Nail & K.C. remon. tag on N face 4" Elm N 10° W 22.95'



Signed by *Randy J. Kolehouse* Date 11/24/97

Surveyor's Michigan License No. 25854