

# SURVEY & REMONUMENTATION

MAR 03 1998

## LAND CORNER RECORDATION CERTIFICATE Filing Requirement of Act 74, Mich. P.A. 1970 KENT COUNTY REMONUMENTATION

STATE OF MICHIGAN  
COUNTY OF KENT  
RECEIVED FOR RECORD  
97 OCT 15 AM 8:48  
REG. OF DEEDS  
*Eric Sand*

### SECTION

For corners in	Kent (County)	Located in: Cannon Township	Corner Code #
1. Public Land Survey		T <u>8N</u> R <u>10W</u>	<u>L-5</u>
		T _____ R _____	_____
		T _____ R _____	_____
		T _____ R _____	_____
2. Property Controlling in Section	S _____	T _____ R _____	_____
	S _____	T _____ R _____	_____
3. Miscellaneous Property in Sec.	S _____	T _____ R _____	_____
	S _____	T _____ R _____	_____
4. Lot No. _____, Recorded Plat _____			
5. Private Claims _____			

10153

Register of Deeds Stamp & File Number

I, Randy Kolehouse, in a field survey on July 1 19 97, do hereby certify that under requirements of P.A. 74 Michigan P.A. of 1970, the corner points mentioned in lines 1 and 2 above were in conformance with regulations and rules therefore as required in the current manual of survey instructions of the United States Department of the interior, Bureau of Land Management or by a decree of a Court of Law and/or that the corner points mentioned in lines 3, 4 and 5 above were in conformance with the rules of the Michigan Board of Land Surveyors or by a Decree of a Court of Law; established, re-established, monumented, re-monumented, recovered, found as expressed below:

	A	B	C	D	E	F	G	H	I	J	K	L	M
2	6		5		4		3		2		1		
3													
4	7		8		9		10		11		12		
5													
6	18		17		16		15		14		13		
7													
8	19		20		21		22		23		24		
9													
10	30		29		28		27		26		25		
11													
12	31		32		33		34		35		36		
13													

NOTE: Not more than 4 corners, all in the same town and range, may be recorded on this certificate.

#### A. Description of original monument and accessories and/or subsequent restoration:

L-5	1831	G.L.O. Notes	Mullett	Set Post	P.A. 345 1990 KENT COUNTY
	1930-19	Witness Map	K.C. Surveyor	Iron	PEER APPROVED 7/24/97
	1971	L.C.R.C. #94	Williams & Works	1-1/2" Iron	CHAIRMAN <i>Henry Kuper</i>
	1981	L.C.R.C. #2449	Jonker Land Survey	Fnd. 3/4" Round Iron / Set K.C. Monument	
	1989	L.C.R.C. #5282	J. Bueche	K.C. Monument	

This corner was originally approved by the Kent County Remonumentation Peer Group and monumented by Rob Jonker on 12/9/81 and was recorded per L.C.R.C. #2449.

#### B. Description of corner evidence found and/or method applied in restoring or reestablishing corner:

L-5 Found a Standard Kent County Monument 30' ± North of the C/L of Belding Road (bit.) running East and West and 150' ± East of the C/L of Old Belding Road running Southwesterly per L.C.R.C.'s #2449 and #5282 as set by Rob Jonker in place of a 3/4" round iron he found which checked L.C.R.C. #94 and the K.C. Surveyor's records.

L.C.R.C. #2449

Remon tag on S. side R.R. tie gate post N 73° W 195.46'  
Remon tag on curb joint S 49° W 130.0'  
Remon tag on curb joint S 65° E 149.56'  
North corner of top of East fence post S 22° E 128.46'  
C/L top broken R.O.W. monument (N 02° E) 11.97'

L.C.R.C. #5282


Remon. tag & nail on S side R.R. tie gate post N 73° W 195.46'  
Remon. tag & nail on curb joint S 49° W 130.0'  
Remon. tag & nail on curb joint S 65° E 149.56'  
North corner of top of East fence post S 22° E 128.46'  
C/L pavement S 00° 47.7' m/l  
C/L blacktop rd. (Old Belding Rd.) S., W. 150' ±

The selected location is accepted by me and is generally accepted by professional surveyors as the best available evidence of the position of the original corner.

#### C. Description of monument for corner and accessories established to perpetuate locating the position of the corner:

L-5 Standard Kent County Monument

Nail & K.C. remon. tag on S side R.R. tie gate post N 73° W 195.46'  
Nail & K.C. remon. tag on curb joint S 49° W 130.00'  
Nail & K.C. remon. tag on curb joint S 65° E 149.56'  
North cor. of top of East fence post S 33° E 128.46'

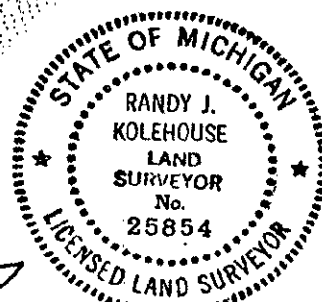

Signed by *Randy J. Kolehouse* Date 9/24/97

Surveyor's Michigan License No. 25854