

SURVEY & REMONUMENTATION

MAR 03 1998

\$7.00
\$2.00

LAND CORNER RECORDATION CERTIFICATE
Filing Requirement of Act 74, Mich. P.A. 1970
KENT COUNTY REMONUMENTATION

For corners in

SECTION

Kent (County)	Located in: Cannon Township	Corner Code #
1. Public Land Survey	T <u>8N</u> R <u>10W</u>	<u>L-7</u>
	T _____ R _____	_____
	T _____ R _____	_____
	T _____ R _____	_____
2. Property Controlling in Section	S _____ T _____ R _____	_____
	S _____ T _____ R _____	_____
3. Miscellaneous Property in Sec.	S _____ T _____ R _____	_____
	S _____ T _____ R _____	_____

REG. OF DEEDS

Lucy Bond

97 NOV 14 AM 9:02


STATE OF MICHIGAN
COUNTY OF KENT
RECEIVED FOR RECORD

10344

Register of Deeds Stamp & File Number

4. Lot No. _____, Recorded Plat _____
5. Private Claims _____

I, Randy Kolehouse, in a field survey on August 18 19 97, do hereby certify that under requirements of P.A. 74 Michigan P.A. of 1970, the corner points mentioned in lines 1 and 2 above were in conformance with regulations and rules therefore as required in the current manual of survey instructions of the United States Department of the Interior, Bureau of Land Management or by a decree of a Court of Law and/or that the corner points mentioned in lines 3, 4 and 5 above were in conformance with the rules of the Michigan Board of Land Surveyors or by a Decree of a Court of Law; established, re-established, monumented, re-monumented, recovered, found as expressed below:

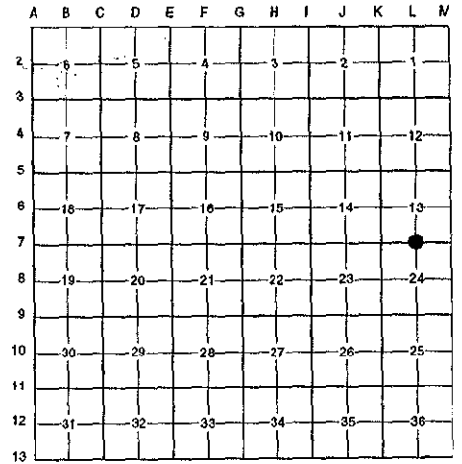

NOTE: Not more than 4 corners, all in the same town and range, may be recorded on this certificate.

A. Description of original monument and accessories and/or subsequent restoration:

L-7	1831	G.L.O. Notes	Mullett	Set Post
	N/A	Witness Map	K.C. Surveyor	N/A
	1983	L.C.R.C. #3489	J. Bueche	Fnd. 1" Iron / Set K.C. Monument
	1989	L.C.R.C. #5283	J. Bueche	K.C. Monument

This corner was originally approved by the Kent County Remonumentation Peer Group and monumented by J. Bueche on 7/25/83 and was recorded per L.C.R.C. #3489.

B. Description of corner evidence found and/or method applied in restoring or reestablishing corner:

L-7 Found a Standard Kent County Monument on line of a fence line running North and 25' ± South of a fence line running East and West per L.C.R.C.'s #3489 and #5283 as set by J. Bueche in place of a 1" iron he found which checked the K.C. Surveyor's records.

L.C.R.C. #3489

L.C.R.C. #5283

Cut nail in N. side 20" Maple S 60° E 29.80'
Cut nail in E. side dbl. 14" Maple S 00° W 19.28'
K.C. Remon. tag & nail W. side 18" W. Cherry S 35° W 47.01'
K.C. Remon. tag & nail N. side 8" W. Cherry N 70° W 38.15'
K.C. Remon. tag & nail N.W. side dbl. 30" Oak N 60° E 54.95'
Cut nail in W side 24" Oak N 20° E 27.87'

Remon. tag & nail W side 20" W. Cherry S 35° W 46.38'
Remon. tag & nail N side 10" W. Cherry N 70° W 38.15'
Remon. tag & nail NW side dbl. 32" Oak N 60° E 54.94'
Remon. tag & nail W side 26" Oak N 20° E 27.83'

P.A. 345 1990 KENT COUNTY

PEER APPROVED 8/28/97


CHAIRMAN *Harry Huber*

The selected location is accepted by me and is generally accepted by professional surveyors as the best available evidence of the position of the original corner.

C. Description of monument for corner and accessories established to perpetuate locating the position of the corner:

L-7 Standard Kent County Monument

Nail & K.C. remon. tag on W side 20" Cherry S 35° W 46.38'
Nail & K.C. remon. tag on N side 10" W. Cherry N 70° W 38.15'
Nail & K.C. remon. tag on NW side dbl. 32" Oak N 60° E 54.94'
Nail & K.C. remon. tag on W side 26" Oak N 20° E 27.83'

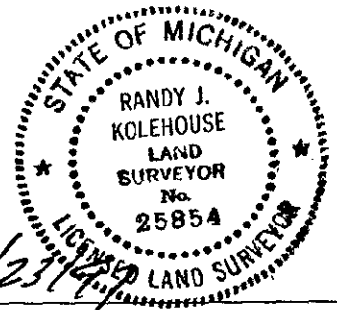

Signed by *Randy J. Kolehouse* Date _____
EARTH TECH
Surveyor's Michigan License No. 25854