

SURVEY & REMONUMENTATION

MAR 03 1998

\$7.00
\$2.00

LAND CORNER RECORDATION CERTIFICATE
Filing Requirement of Act 74, Mich. P.A. 1970
KENT COUNTY REMONUMENTATION

For corners in SECTION

Kent (County)	Located in: Cannon Township	Corner Code #
1. Public Land Survey	T <u>8N</u> R <u>10W</u>	<u>L-8</u>
	T _____ R _____	_____
	T _____ R _____	_____
	T _____ R _____	_____
2. Property Controlling in Section	S _____ T _____ R _____	_____
	S _____ T _____ R _____	_____
3. Miscellaneous Property in Sec.	S _____ T _____ R _____	_____
	S _____ T _____ R _____	_____


STATE OF MICHIGAN
COUNTY OF KENT
RECEIVED FOR RECORD
97 DEC 15 AM 10:45
REG. OF DEEDS
W. J. Bond

10417

Register of Deeds Stamp & File Number

- 4. Lot No. _____, Recorded Plat _____
- 5. Private Claims _____

I, Randy Kolehouse, in a field survey on July 1 19 97, do hereby certify that under requirements of P.A. 74 Michigan P.A. of 1970, the corner points mentioned in lines 1 and 2 above were in conformance with regulations and rules therefore as required in the current manual of survey instructions of the United States Department of the interior, Bureau of Land Management or by a decree of a Court of Law and/or that the corner points mentioned in lines 3, 4 and 5 above were in conformance with the rules of the Michigan Board of Land Surveyors or by a Decree of a Court of Law; established, re-established, monumented, re-monumented, recovered, found as expressed below:

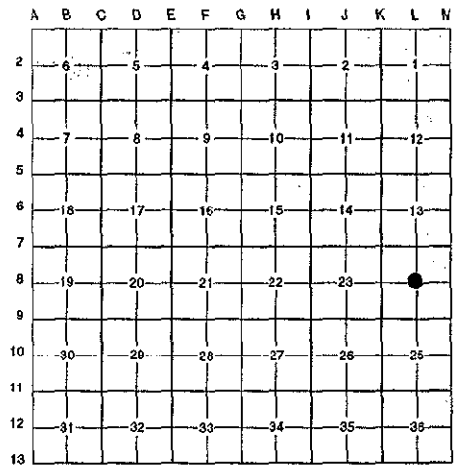

NOTE: Not more than 4 corners, all in the same town and range, may be recorded on this certificate.

A. Description of original monument and accessories and/or subsequent restoration:

L-8	This corner was not originally set by the G.L.O.
1941	Witness Map K.C. Surveyor 1" Iron
1968	Survey Records Williams & Works Set "T" Iron @ Int. 1/4 Lines
1978	L.C.R.C. #1152 Williams & Works "T" Iron

P.A. 345 1990 KENT COUNTY
PEER APPROVED 11/20/97
CHAIRMAN *Harry Huber*

B. Description of corner evidence found and/or method applied in restoring or reestablishing corner:

L-8 Found a "T" iron 3' North of the C/L of Krueter Road (bit.) running East and West as set by Williams & Works in 1968 at the intersection of 1/4 lines per L.C.R.C. #1152 and the K.C. Surveyor's records. "T" iron is 0.1' North and 0.4' West of the intersection of 1/4 lines. Accepted "T" iron as Center of Section.


L.C.R.C. #1152

- Twin 6" Oak N - 34.90'
- 14" Oak N 45° W - 46.65' (m. 46.80')
- 10" Oak S 05° W - 38.44'

The selected location is accepted by me and is generally accepted by professional surveyors as the best available evidence of the position of the original corner.

C. Description of monument for corner and accessories established to perpetuate locating the position of the corner:

- L-8 Replaced "T" Iron with a Standard Kent County Monument
 - Nail & K.C. remon. tag on E side 14" Oak North 29.50'
 - Nail & K.C. remon. tag on NE side 5 x 5 fence post S 40° E 44.10'
 - Nail & K.C. remon. tag on W side 8" Oak S 10° W 35.15'
 - Nail & K.C. remon. tag on S side 14" Oak N 35° W 46.80'

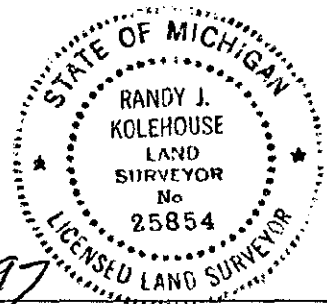

Signed by *Randy J. Kolehouse*
EARTH TECH

Date 11/24/97

Surveyor's Michigan License No. 25854