

SURVEY & REMONUMENTATION

MAR 03 1998

LAND CORNER RECORDATION CERTIFICATE Filing Requirement of Act 74, Mich. P.A. 1970 KENT COUNTY REMONUMENTATION

REG. OF DEEDS
David J. ...

STATE OF MICHIGAN
COUNTY OF KENT
RECEIVED FOR RECORD
97 OCT 15 AM 8:48

For corners in **SECTION**

Kent (County)	Located in: Cannon Township	Corner Code #
1. Public Land Survey	T <u>8N</u> R <u>10W</u>	<u>L-11</u>
	T _____ R _____	_____
	T _____ R _____	_____
	T _____ R _____	_____
2. Property Controlling in Section	S _____ T _____ R _____	_____
	S _____ T _____ R _____	_____
3. Miscellaneous Property in Sec.	S _____ T _____ R _____	_____
	S _____ T _____ R _____	_____

10155

Register of Deeds Stamp & File Number

4. Lot No. _____, Recorded Plat _____
5. Private Claims _____

I, Randy Kolehouse, in a field survey on June 30 19 97, do hereby certify that under requirements of P.A. 74 Michigan P.A. of 1970, the corner points mentioned in lines 1 and 2 above were in conformance with regulations and rules therefore as required in the current manual of survey instructions of the United States Department of the interior, Bureau of Land Management or by a decree of a Court of Law and/or that the corner points mentioned in lines 3, 4 and 5 above were in conformance with the rules of the Michigan Board of Land Surveyors or by a Decree of a Court of Law; established, re-established, monumented, re-monumented, recovered, found as expressed below:

NOTE: Not more than 4 corners, all in the same town and range, may be recorded on this certificate.

A. Description of original monument and accessories and/or subsequent restoration:

L-11	1831	G.L.O. Notes	Mullett	Set Post
	1938	Witness Map	K.C. Surveyor	Monument
	1977	L.C.R.C. #3307	Glaza & Associates	N/A
	1984	L.C.R.C. #3872	M. Rosema	Fnd. 1/2" Iron in Mon. Box / Set K.C. Monument in Mon. Box
	1989	L.C.R.C. #5285	J. Bueche	K.C. Monument in Mon. Box

This corner was originally approved by the Kent County Remonumentation Peer Group and monumented by M. Rosema on 7/16/84 and was recorded per L.C.R.C. #3872.

B. Description of corner evidence found and/or method applied in restoring or reestablishing corner:

L-11 Found a Standard Kent County Monument in a monument box 1' North and 2' West of the C/L intersection of 5 Mile Road (bit.) running East and West and Mc Cabe Avenue (bit.) running South per L.C.R.C.'s #3872 and #5285 as set by M. Rosema in place of a 1/2" iron pipe he found in a monument box which checked L.C.R.C. #3307 and the K.C. Surveyor's records.

L.C.R.C. #3872

L.C.R.C. #5285

SE corner concrete block house (2' above ground) - N 37° W 114.38'
Nail and remon tag in W. side wood fence post - S 23° E 95.55'
Nail and remon tag in E. side wood fence post - N 09° E 50.49'

SE corner concrete block house (2' above ground) N 37° W 114.38'
Nail & remon. tag in W side wood fence post S 23° E 95.55'
Nail & remon. tag in E side wood fence post N 09° E 50.49'
Nail & remon. tag in SW side PP S 50° E 76.08'


The selected location is accepted by me and is generally accepted by professional surveyors as the best available evidence of the position of the original corner.

C. Description of monument for corner and accessories established to perpetuate locating the position of the corner:

L-11 Standard Kent County Monument in a Monument Box

- Nail & K.C. remon. tag on W side wood fence post S 23° E 95.55'
- Nail & K.C. remon. tag on E side wood fence post N 09° E 50.49'
- Nail & K.C. remon. tag on SW side P. pole S 50° E 76.08'
- SE cor. conc. block hse. (2' above grd.) N 37° W 114.38'

P.A. 345 1990 KENT COUNTY,
PEER APPROVED 7/24/97
CHAIRMAN Harry ...

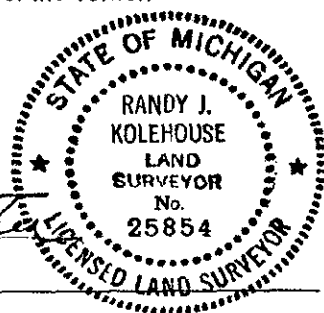

Signed by Randy J. Kolehouse Date 8/12/97

Surveyor's Michigan License No. 25854