

SURVEY & REMONUMENTATION

MAR 03 1998

LAND CORNER RECORDATION CERTIFICATE
Filing Requirement of Act 74, Mich. P.A. 1970
 KENT COUNTY REMONUMENTATION

STATE OF MICHIGAN
 COUNTY OF KENT
 RECEIVED FOR RECORD
 97 NOV 14 AM 9:02
 REG. OF DEEDS
Lucy Bond

SECTION
 For corners in

Kent (County)	Located in: Cannon Township	Corner Code #
1. Public Land Survey	T <u>8N</u> R <u>10W</u>	<u>M-3</u>
	T _____ R _____	_____
	T _____ R _____	_____
	T _____ R _____	_____
2. Property Controlling in Section	S _____ T _____ R _____	_____
	S _____ T _____ R _____	_____
3. Miscellaneous Property in Sec.	S _____ T _____ R _____	_____
	S _____ T _____ R _____	_____

10345

Register of Deeds Stamp & File Number

- 4. Lot No. _____, Recorded Plat _____
- 5. Private Claims _____


I, Randy Kolehouse, in a field survey on August 15 19 97, do hereby certify that under requirements of P.A. 74 Michigan P.A. of 1970, the corner points mentioned in lines 1 and 2 above were in conformance with regulations and rules therefore as required in the current manual of survey instructions of the United States Department of the interior, Bureau of Land Management or by a decree of a Court of Law and/or that the corner points mentioned in lines 3, 4 and 5 above were in conformance with the rules of the Michigan Board of Land Surveyors or by a Decree of a Court of Law; established, re-established, monumented, re-monumented, recovered, found as expressed below:

NOTE: Not more than 4 corners, all in the same town and range, may be recorded on this certificate.

A. Description of original monument and accessories and/or subsequent restoration:

M-3	1831	G.L.O. Notes	Mullett	Set Post
	N/A	Witness Map	K.C. Surveyor	Iron
	1971	L.C.R.C. #71	Williams & Works	1" Iron
	1980	L.C.R.C. #1469	Williams & Works	Fnd. 1" Iron / Set K.C. Monument
	1989	L.C.R.C. #5288	J. Bueche	K.C. Monument

P.A. 345 1990 KENT COUNTY
 PEER APPROVED 8/28/97
 CHAIRMAN Randy Kolehouse

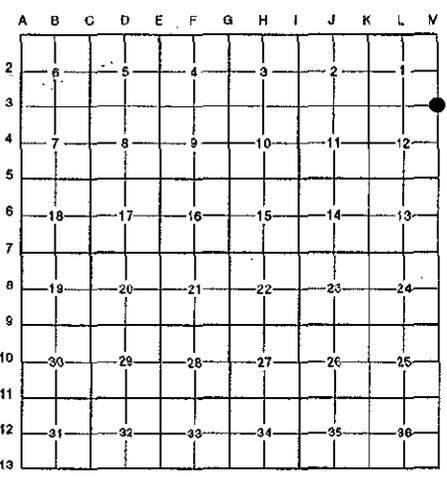

Note: This corner is common with A-3, T8N, R9W.

This corner was originally approved by the Kent County Remonumentation Peer Group and monumented by Williams & Works on 5/7/71 and was recorded per L.C.R.C. #1469.

B. Description of corner evidence found and/or method applied in restoring or reestablishing corner:

M-3 Found a Standard Kent County Monument 320' West of the C/L of Tiffany Avenue (gravel) running North and South and 200' ± South of path running West per L.C.R.C.'s #1469 and #5288 as set by Williams & Works in place of a 1" iron they found in stones which checked L.C.R.C. #213 and the K.C. Surveyor's records.

L.C.R.C. #1469	L.C.R.C. #5288
Nail & K.C. Remon. Tag East Side 8" Oak N 45° 39.68'	Nail & remon. tag E side 10" Oak N 45° E 39.71'
Nail & K.C. Remon. Tag East Side 8" Oak N 15° E 24.70'	Nail & remon. tag E side 10" Oak N 15° E 24.98' (m. 25.00')
Nail & K.C. Remon. Tag South Side 12" Oak N 65° W 33.55'	Nail & remon. tag S side 12" Oak N 65° W 33.55'
Nail & K.C. Remon. Tag North Side 22" Oak N 90° W 59.45'	Nail & remon. tag N side 26" Oak N 90° W 59.45'
Nail & K.C. Remon. Tag South Side 8" Poplar S 75° E 42.46'	Nail & remon. tag S side 12" Poplar S 75° E 42.63'

The selected location is accepted by me and is generally accepted by professional surveyors as the best available evidence of the position of the original corner.

C. Description of monument for corner and accessories established to perpetuate locating the position of the corner:

- M-3 Standard Kent County Monument
- Nail & K.C. remon. tag on E side 10" Oak N 15° E 25.00'
 - Nail & K.C. remon. tag on E side 10" Oak N 45° E 39.71'
 - Nail & K.C. remon. tag on S side 12" Oak N 65° W 33.55'
 - Nail & K.C. remon. tag on N side 26" Oak N 90° W 59.45'



Signed by Randy J. Kolehouse Date 9/23/97
 EARTHTECH
 Surveyor's Michigan License No. 25854