

SURVEY & REMONUMENTATION

MAR 03 1998

LAND CORNER RECORDATION CERTIFICATE
Filing Requirement of Act 74, Mich. P.A. 1970
KENT COUNTY REMONUMENTATION

STATE OF MICHIGAN
 COUNTY OF KENT
 RECEIVED FOR RECORD
 97 OCT 15 AM 8:48
 REG. OF DEEDS
Lucy Spauld

For corners in **SECTION**


<u>Kent</u> (County)	Located in: Cannon Township	Corner Code #
1. Public Land Survey	T <u>8N</u> R <u>10W</u>	<u>M-4</u>
	T _____ R _____	_____
	T _____ R _____	_____
	T _____ R _____	_____
2. Property Controlling in Section	S _____ T _____ R _____	_____
	S _____ T _____ R _____	_____
3. Miscellaneous Property in Sec.	S _____ T _____ R _____	_____
	S _____ T _____ R _____	_____

10159

Register of Deeds Stamp & File Number

4. Lot No. _____, Recorded Plat _____
 5. Private Claims _____

I, Randy Kolehouse, in a field survey on July 1 19 97, do hereby certify that under requirements of P.A. 74 Michigan P.A. of 1970, the corner points mentioned in lines 1 and 2 above were in conformance with regulations and rules therefore as required in the current manual of survey instructions of the United States Department of the interior, Bureau of Land Management or by a decree of a Court of Law and/or that the corner points mentioned in lines 3, 4 and 5 above were in conformance with the rules of the Michigan Board of Land Surveyors or by a Decree of a Court of Law; established, re-established, monumented, re-monumented, recovered, found as expressed below:

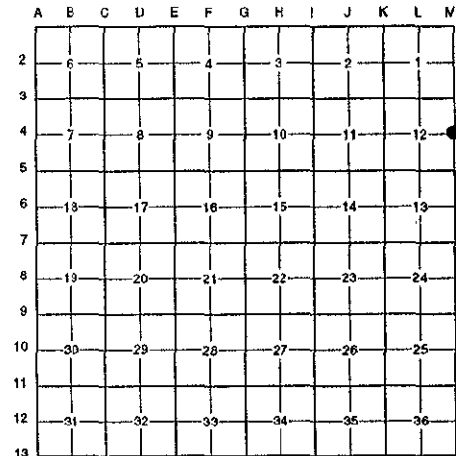

NOTE: Not more than 4 corners, all in the same town and range, may be recorded on this certificate.

A. Description of original monument and accessories and/or subsequent restoration:

M-4	1831	G.L.O. Notes	Mullett	Set Post
	N/A	Witness Map	K.C. Surveyor	Iron
	1971	L.C.R.C. #71	Williams & Works	1" Iron
	1978	L.C.R.C. #1177	Medema, Van Kooten & Assoc.	3/4" Iron (A-4, T8N, R9W)
	1981	L.C.R.C. #1900	Jonker Land Surveys	Fnd. 1" Iron / Set K.C. Monument
	1989	L.C.R.C. #5289	J. Bueche	K.C. Monument

P.A. 345 1990 KENT COUNTY
 PEER APPROVED 7/24/97
 CHAIRMAN *[Signature]*

Note: This corner is common with A-4, T8N, R9W.

This corner was originally approved by the Kent County Remonumentation Peer Group and monumented by Rob Jonker on 7/15/81 and was recorded per L.C.R.C. #1900.

B. Description of corner evidence found and/or method applied in restoring or reestablishing corner:

M-4 Found a Standard Kent County Monument at the C/L intersection of Tiffany Avenue (gravel) running North and South and Whitten Road (gravel) running East per L.C.R.C.'s #1900 and #5289 as set by Rob Jonker in place of a 1" iron he found which checked L.C.R.C.'s #1177, #71, and the K.C. Surveyor's records.

L.C.R.C. #1900

Remon. tag on E side 24" Oak N 20° E 97.42'
 Remon. tag on SE side 6" Pine N 60° E 73.54'
 Remon. tag on S side 9" Oak N 88° E 154.39'
 C/L S. leg traffic sign S 80 W 17.2'

L.C.R.C. #5289


Remon. tag & nail on E side 26" Oak N 20° E 97.35'
 Remon. tag & nail on SE side 8" Pine N 60° E 73.65'
 Remon. tag & nail on S side 12" Oak N 88° E 154.39'
 E. face S. leg of sign S 90° W 19.84'

The selected location is accepted by me and is generally accepted by professional surveyors as the best available evidence of the position of the original corner.

C. Description of monument for corner and accessories established to perpetuate locating the position of the corner:

M-4 Standard Kent County Monument

Nail & K.C. remon. tag on E side 26" Oak N 20° E 97.35'
 Nail & K.C. remon. tag on SE side 8" Pine N 60° E 73.65'
 Nail & K.C. remon. tag on S side 12" Oak N 88° E 154.39'
 East face South leg of sign S 90° W 19.84'

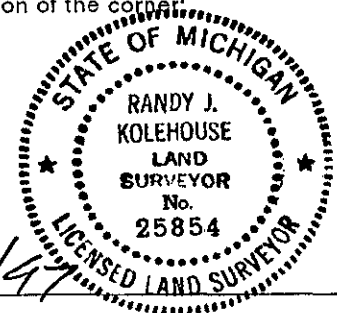

Signed by *Randy J. Kolehouse* Date 8/12/97
 EARTH TECH

Surveyor's Michigan License No. 25854