

# SURVEY & REMONUMENTATION

**MAR 03 1998**

## LAND CORNER RECORDATION CERTIFICATE Filing Requirement of Act 74, Mich. P.A. 1970 KENT COUNTY REMONUMENTATION

For corners in  
Kent SECTION  
(County)

	Located in: Cannon Township	Corner Code #
1. Public Land Survey	T <u>8N</u> R <u>10W</u>	<u>M-6</u>
	T _____ R _____	_____
	T _____ R _____	_____
	T _____ R _____	_____
2. Property Controlling in Section	S _____ T _____ R _____	_____
	S _____ T _____ R _____	_____
3. Miscellaneous Property in Sec.	S _____ T _____ R _____	_____
	S _____ T _____ R _____	_____

STATE OF MICHIGAN  
 COUNTY OF KENT  
 RECEIVED FOR RECORD  
 97 OCT 15 AM 8:48  
 REG. OF DEEDS  
*Luis J. Kulehouse*

10161

Register of Deeds Stamp & File Number

4. Lot No. \_\_\_\_\_, Recorded Plat \_\_\_\_\_  
 5. Private Claims \_\_\_\_\_

	A	B	C	D	E	F	G	H	I	J	K	L	M
2	6	5	4	3	2	1							
3													
4	7	8	9	10	11	12							
5													
6	18	17	16	15	14	13							
7													
8	19	20	21	22	23	24							
9													
10	30	29	28	27	26	25							
11													
12	31	32	33	34	35	36							
13													

I, Randy Kolehouse, in a field survey on July 1 19 97, do hereby certify that under requirements of P.A. 74 Michigan P.A. of 1970, the corner points mentioned in lines 1 and 2 above were in conformance with regulations and rules therefore as required in the current manual of survey instructions of the United States Department of the interior, Bureau of Land Management or by a decree of a Court of Law and/or that the corner points mentioned in lines 3, 4 and 5 above were in conformance with the rules of the Michigan Board of Land Surveyors or by a Decree of a Court of Law; established, re-established, monumented, re-monumented, recovered, found as expressed below:

**NOTE: Not more than 4 corners, all in the same town and range, may be recorded on this certificate.**

**A. Description of original monument and accessories and/or subsequent restoration:**

M-6	1831	G.L.O. Notes	Mullett	Set Post
	1972	L.C.R.C. #162	Medema, Van Kooten & Assoc.	"T" Iron
	1973	L.C.R.C. #758	G. Fauser	"T" Iron (A-6, T8N, R9W)
	1981	L.C.R.C. #1902	Jonker Land Survey	Fnd. "T" Iron / Set K.C. Monument
	1989	L.C.R.C. #5291	J. Bueche	K.C. Monument

Note: This corner is common with A-6, T8N, R9W.

This corner was originally approved by the Kent County Remonumentation Peer Group and monumented by Rob Jonker on 7/16/81 and was recorded per L.C.R.C. #1902.

**B. Description of corner evidence found and/or method applied in restoring or reestablishing corner:**

M-6 Found a Standard Kent County Monument (.8' below grade) 3' West of the C/L of Tiffany Avenue (gravel) running North and South per L.C.R.C.'s #1902 and #5291 as set by Rob Jonker in place of a "T" iron he found which checked L.C.R.C.'s #758 and #162.

L.C.R.C. #1902

Remon. tag on E side 16" Oak S 22° W 64.09'  
 Remon. tag on N side 36" Maple N 61° E 27.79'  
 Remon. tag on N side 36" Maple S 87° E 33.88'  
 Remon. tag on SW side 24" Oak S 42° E 50.53'

L.C.R.C. #5291

Remon. tag & nail on E side 18" Oak S 32° W 64.14'  
 Cut nail on N side 40" Maple N 61° E 27.79'


P.A. 345 1990 KENT COUNTY  
 PEER APPROVED 7/24/97  
 CHAIRMAN *Harry Thubert*

The selected location is accepted by me and is generally accepted by professional surveyors as the best available evidence of the position of the original corner.

**C. Description of monument for corner and accessories established to perpetuate locating the position of the corner:**

M-6 Standard Kent County Monument

Nail & K.C. remon. tag on E side 18" Oak S 22° W 64.14'  
 Nail & K.C. remon. tag on N side 40" Maple N 61° E 27.79'  
 Nail & K.C. remon. tag on N side 40" Maple S 87° E 32.06'  
 Nail & K.C. remon. tag on SW side 26" Oak S 42° E 49.71'

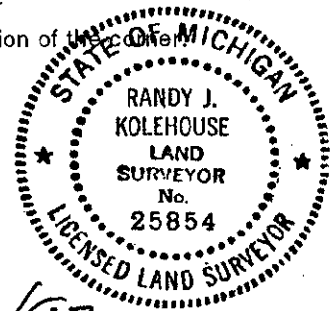

Signed by *Randy J. Kolehouse* Date 8/12/97  
 EARTH TECH

Surveyor's Michigan License No. 25854