

**SURVEY & REMONUMENTATION**

FEB 14 1997

**KENT COUNTY REMONUMENTATION**

**COMMISSION LAND CORNER RECORDATION CERTIFICATE**  
Filing Requirement of Act 74, Mich. P.A. 1970

For corners in  
**KENT COUNTY**  
(County)

Located In:	Corner Code #
T8N R11W	B-3
T___ R___	_____
T___ R___	_____
T___ R___	_____
S___ T___ R___	_____
S___ T___ R___	_____
S___ T___ R___	_____
S___ T___ R___	_____

1. Public Land Survey

2. Property Controlling in Section

3. Miscellaneous Property in Sec.

4. Lot No. \_\_\_\_\_, Recorded Plat \_\_\_\_\_  
5. Private Claims \_\_\_\_\_

REG. OF DEEDS

*Lucy Spauld*

96 MAR 20 AM 8:51


STATE OF MICHIGAN  
COUNTY OF KENT  
RECEIVED FOR RECORD

9027

Register of Deeds Stamp & File Number

I, **Kirk Breitels**, in a field survey on **Jan. 18, 1996** do hereby state that under requirements of P.A. 74, Michigan P.A. of 1970, the corner points mentioned in lines 1 and 2 above were in conformance with regulations and rules therefore as required in the current manual of survey instructions of the United States Department of the Interior, Bureau of Land Management or by a decree of a Court of Law and/or that the corner points mentioned in lines 3, 4 and 5 above were in conformance with the rules of the Michigan Board of Land Surveyors or by a Decree of a Court of Law; established, re-established, monumented, recovered, found as expressed below:

NOTE: Not more than 2 corners, all in the same town and range, may be recorded on this certificate.

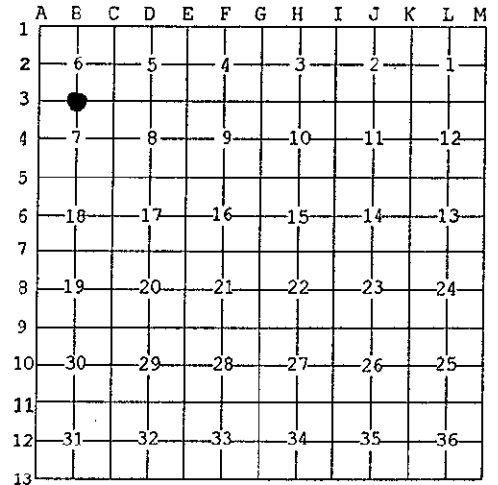

A. Description of original monument and accessories and/or subsequent restoration:

B-3	1837	GLO	Whitcomb	Set Post
	1930	Kent Co. Wit.		Stone
	1972	LCRC #286	VanKooten	"T" Iron
	1981	LCRC #2264	Bueche	Set Kent County Monument
	1994	LCRC #6893	Byl	Kent County Monument

P.A. 345 1990 KENT COUNTY

PEER APPROVED *3/7/96*

CHAIRMAN *Harry Stuber*

The position of this corner was previously approved by the Kent County Remonumentation Peer Group, monumented by John C. Bueche on 10/31/81 and was recorded per LCRC #2264.

B. Description of corner evidence found and/or method applied in restoring or reestablishing corner:

B-3 Found standard Kent Co. Mon. (Harrison) per witnesses from above LCRC as set by John C. Bueche in place of the "T" Iron he found on top of a Stone. Said "T" Iron checks with Kent Co. Wit. and LCRC #286.

LCRC #2264 & #6893

Nail & KC Remon. tag W. side P. Pole	S05°E	47.83'	NE cor. hse. fnd.
Nail & KC Remon. tag SW side 42" Oak	N30°W	46.78'	(most N'y NE cor.)
Nail & KC Remon. tag W. side 14" Maple	N40°E	40.30'	S35°W 91.57'
Nail & KC Remon. tag S. side P. Pole	N70°W	64.83'	C/L blktp. E-W is S. 2'±
Nail & KC Remon. tag W. side 27" Maple	N20°E	77.63'	On C/L blktp. N.

The selected location is accepted by me and is generally accepted by professional surveyors as the best available evidence of the position of the original corner.

C. Description of monument for corner and accessories established to perpetuate locating the position of the corner:

B-3 Standard Kent County Monument

Nail & KC Remon. tag W. side P. Pole	S05°E	47.83'
Nail & KC Remon. tag SW side 48" Oak	N30°W	46.85'
Nail & KC Remon. tag S. side P. Pole	N70°W	64.83'
Nail & KC Remon. tag W. side 27" Maple	N20°E	77.63'
NE cor. house fnd. (most N'y NE cor.)	S35°W	91.57'
Set Nail & KC Remon. tag S. side 26" Walnut	N80°E	77.86'
C/L blktp. E-W is S. 2'±		On C/L blktp. N.



Signed by *Kirk Breitels*  
Surveyor's Michigan License No. 30077

Date 2/6/96