

72  
 REMONUMENTATION  
 FEB 14 1997  
 COMMISSION

KENT COUNTY REMONUMENTATION  
 LAND CORNER RECORDATION CERTIFICATE  
 Filing Requirement of Act 74, Mich. P.A. 1970

For corners in  
**KENT COUNTY**  
 (County)

Located In: T8N R 11W Corner Code # B-8

1. Public Land Survey T R \_\_\_\_\_  
T R \_\_\_\_\_  
T R \_\_\_\_\_  
T R \_\_\_\_\_

2. Property Controlling in Section S T R \_\_\_\_\_  
S T R \_\_\_\_\_  
S T R \_\_\_\_\_  
S T R \_\_\_\_\_

3. Miscellaneous Property in Sec. \_\_\_\_\_

4. Lot No. \_\_\_\_\_, Recorded Plat \_\_\_\_\_

5. Private Claims \_\_\_\_\_

STATE OF MICHIGAN  
 COUNTY OF KENT  
 RECEIVED FOR RECORD

96 SEP 13 PM 12:05

REG. OF DEEDS  
*Lucy Spauld*

9358

Register of Deeds Stamp & File Number

|    |    |    |    |    |    |    |   |   |   |   |   |   |
|----|----|----|----|----|----|----|---|---|---|---|---|---|
| A  | B  | C  | D  | E  | F  | G  | H | I | J | K | L | M |
| 2  | 6  | 5  | 4  | 3  | 2  | 1  |   |   |   |   |   |   |
| 3  |    |    |    |    |    |    |   |   |   |   |   |   |
| 4  | 7  | 8  | 9  | 10 | 11 | 12 |   |   |   |   |   |   |
| 5  |    |    |    |    |    |    |   |   |   |   |   |   |
| 6  | 18 | 17 | 16 | 15 | 14 | 13 |   |   |   |   |   |   |
| 7  |    |    |    |    |    |    |   |   |   |   |   |   |
| 8  | 19 | 20 | 21 | 22 | 23 | 24 |   |   |   |   |   |   |
| 9  |    |    |    |    |    |    |   |   |   |   |   |   |
| 10 | 30 | 29 | 28 | 27 | 26 | 25 |   |   |   |   |   |   |
| 11 |    |    |    |    |    |    |   |   |   |   |   |   |
| 12 | 31 | 32 | 33 | 34 | 35 | 36 |   |   |   |   |   |   |
| 13 |    |    |    |    |    |    |   |   |   |   |   |   |

I, Kirk Breitels, in a field survey on Aug. 29, 1996 do hereby state that under requirements of P.A. 74, Michigan P.A. of 1970, the corner points mentioned in lines 1 and 2 above were in conformance with regulations and rules therefore as required in the current manual of survey instructions of the United States Department of the Interior, Bureau of Land Management or by a decree of a Court of Law and/or that the corner points mentioned in lines 3, 4 and 5 above were in conformance with the rules of the Michigan Board of Land Surveyors or by a Decree of a Court of Law; established, re-established, monumented, recovered, found as expressed below:

NOTE: Not more than 2 corners, all in the same town and range, may be recorded on this certificate.

A. Description of original monument and accessories and/or subsequent restoration:

- B-8 1837--GLO--Not Set 1910--Williams & Works--Set Stake & Stone at int. 1/4 lines
- 1938--55--Williams & Works--Found Stone, Set Iron
- 12" Oak N 20.05' 8" Cherry WNW 40.3' 6" Oak S 6.25
- 1964--Kent Co. Wit.--3/4" Iron from MSHD
- 12" Oak NW 37.49' 15" Tw. Oak SE 5.11' 8" Oak WSW 19.25'
- 1975--Survey--Exxel Eng.--1/2" Solid Rod
- 13" Oak NW 37.44' Tw. Oak SE 5.11' 8" Oak SSE 6.35' 10" Tw. Oak WSW 50.69'
- 1981--LCRC #2072--Nederveld--1" Round Iron
- 10" Oak SSE 6.58' 9" Tw. Oak WSW 51.1' 15" Oak NW 37.48' 1/2" Rod SW 0.4'

B. Description of corner evidence found and/or method applied in restoring or reestablishing corner:


B-8 Found 1/2" Rerod per the following witnesses:  
 MSHD tag 18" Oak NW 37.48' Tw. 12" Oak WSW 51'

P.A. 345 1990 KENT COUNTY  
 PEER APPROVED 8/22/96  
 CHAIRMAN [Signature]

This 1/2" Rerod is in a grav. drive - reset since LCRC #2072 - same location ±  
 C 1/4 cor. per LCRC #2072 used in "Western Plains Estates No. 2" (L. 95, Pg. 27)  
 The Iron per 1975 Exxel survey was 0.4' NE of Iron per LCRC #2072.  
 Said 1/2" Rerod is 0.2' S. and 0.4' E. from intersection of 1/4 lines and agrees with survey measurements of others.  
 The 1/2" Rerod is accepted by me and is generally accepted by professional surveyors as the best available evidence of the position of the corner.

C. Description of monument for corner and accessories established to perpetuate locating the position of the corner:

- B-8 Set Standard Kent County Monument in place of 1/2" Rerod
- Set Nail & KC Remon. tag S. side 18" Oak S70°E 15.28'
- Set Nail & KC Remon. tag W. side 18" Oak S05°W 41.50'
- Set Nail & KC Remon. tag SE side Tw. 12" Oak S60°W 51.20'
- Set Nail & KC Remon. tag SW side 18" Oak N30°W 37.51'
- SE cor. steel electric box #3140 N10°E 26.96'
- In C/L grav. drive (curve area)

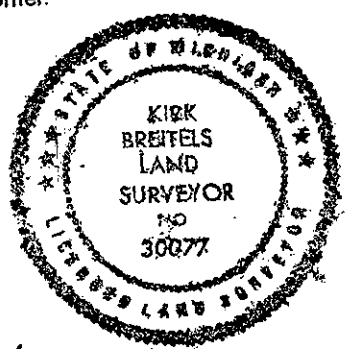

Signed by [Signature]  
 Surveyor's Michigan License No. 30077

Date 9/4/96