

SURVEY & REMONUMENTATION

FEB 14 1997

KENT COUNTY REMONUMENTATION

COMMISSION

LAND CORNER RECORDATION CERTIFICATE
Filing Requirement of Act 74, Mich. P.A. 1970

For corners in
KENT COUNTY
(County)

Located In:	Corner Code #
T 8N R 11W	B-10
T _____ R _____	_____
T _____ R _____	_____
T _____ R _____	_____
S _____ T _____ R _____	_____
S _____ T _____ R _____	_____
S _____ T _____ R _____	_____
S _____ T _____ R _____	_____

- 1. Public Land Survey
- 2. Property Controlling in Section
- 3. Miscellaneous Property in Sec.

4. Lot No. _____, Recorded Plat _____
5. Private Claims _____

I, Kirk Breitels, in a field survey on Sept. 12, 1996 do hereby state that under requirements of P.A. 74, Michigan P.A. of 1970, the corner points mentioned in lines 1 and 2 above were in conformance with regulations and rules therefore as required in the current manual of survey instructions of the United States Department of the Interior, Bureau of Land Management or by a decree of a Court of Law and/or that the corner points mentioned in lines 3, 4 and 5 above were in conformance with the rules of the Michigan Board of Land Surveyors or by a Decree of a Court of Law, established, re-established, monumented, recovered, found as expressed below:

NOTE: Not more than 2 corners, all in the same town and range, may be recorded on this certificate.

1	A	B	C	D	E	F	G	H	I	J	K	L
2		6		5		4		3		2		1
3												
4		7		8		9		10		11		12
5												
6		10		17		16		15		14		13
7												
8		19		20		21		22		23		24
9												
10		30		29		28		27		26		25
11												
12		31		32		33		34		35		36
13												

A. Description of original monument and accessories and/or subsequent restoration:

- B-10 1837---GLO---Not Set 1920---Williams & Works---Stake
- 1940-67---Williams & Works---Conc. Mon. (1963 - Iron, maybe Conc. Mon.)
- 15" Basswood NE 65.40' 10" Basswood SSW 42.60' 14" Oak W 35.80'
- 1964---Kent Co. Wit.---3/4" Iron (per MSHD)
- MBT NNE 71.59' 8" Maple NE 42.84' 36" Oak W 41.0' 10" Maple NNW 41.08'
- 1972---LCRC #332---Spicer---3/4" Iron 3' E. of W. edge of bltp.
- MBT N35°E 71.59' 8" Maple N45°E 42.8' 36" Oak W 41.0'
- 1983---LCRC #3203---Milliron---3/4" Iron
- 14" Maple NNW 40.99' P. Pole NNE 71.54' 10" Poplar W 13.72'

B. Description of corner evidence found and/or method applied in restoring or reestablishing corner:


- B-10 Found Capped (#31604) Iron per the following witnesses:
- Nail side 18" Maple NNW 40.99' C/L 40" Oak W 36'±
- Nail side Tel. Pole NNE 71.56' Nail side 14" Maple N45°E 42.57'

Said Capped Iron is 0.1' E. and 16.9' N. from intersection of 1/4 lines and was used per surveys of Chettleburgh, E. Glaza, Medema & VanKooten, R. Jonker, Exxel and Prien & Newhof.

The Capped Iron is accepted by me and is generally accepted by professional surveyors as the best available evidence of the position of the corner.

C. Description of monument for corner and accessories established to perpetuate locating the position of the corner:

- B-10 Set Standard Kent County Monument in place of Capped Iron
- Set Nail & KC Remon. tag N. side 48" Oak S90°W 35.50'
- Set Nail & KC Remon. tag E. side 18" Walnut N15°W 40.99'
- Nail & MDSH tag E. side Tele. Pole N30°E 71.56'
- Set Nail & KC Remon. tag W. side 14" Maple N45°E 42.50'
- Set Nail & KC Remon. tag S. side Tw. 24" Oak S85°E 46.88'
- W. edge asph. road is W. 4'±

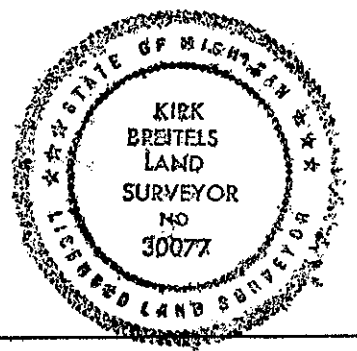

Signed by Kirk Breitels
Surveyor's Michigan License No. 30077

Date 10/11/96

P.A. 345 1990 KENT COUNTY
PEER APPROVED 8/22/96
CHAIRMAN Henry Hubert