

SURVEY & REMONUMENTATION

FEB 14 1997

COMMISSION

KENT COUNTY REMONUMENTATION

LAND CORNER RECORDATION CERTIFICATE
Filing Requirement of Act 74, Mich. P.A. 1970

For corners in

KENT COUNTY

(County)

Located in:

Corner Code #

- | | | |
|------------------------------------|---|-------------|
| 1. Public Land Survey | T <u>8N</u> R <u>11W</u> | <u>C-4</u> |
| | T <u> </u> R <u> </u> | <u> </u> |
| | T <u> </u> R <u> </u> | <u> </u> |
| | T <u> </u> R <u> </u> | <u> </u> |
| 2. Property Controlling in Section | S <u> </u> T <u> </u> R <u> </u> | <u> </u> |
| | S <u> </u> T <u> </u> R <u> </u> | <u> </u> |
| 3. Miscellaneous Property in Sec. | S <u> </u> T <u> </u> R <u> </u> | <u> </u> |
| | S <u> </u> T <u> </u> R <u> </u> | <u> </u> |

STATE OF MICHIGAN
COUNTY OF KENT
RECEIVED FOR RECORD
96 MAR 20 AM 8:52
REG. OF DEEDS
Eric J. Howard

9034

Register of Deeds Stamp & File Number

4. Lot No. _____, Recorded Plat _____
5. Private Claims _____

I, Kirk Breitels, in a field survey on Jan. 19, 19 96 do hereby state that under requirements of P.A. 74, Michigan P.A. of 1970, the corner points mentioned in lines 1 and 2 above were in conformance with regulations and rules therefore as required in the current manual of survey instructions of the United States Department of the Interior, Bureau of Land Management or by a decree of a Court of Law and /or that the corner points mentioned in lines 3, 4 and 5 above were in conformance with the rules of the Michigan Board of Land Surveyors or by a Decree of a Court of Law; established, re-established, monumented, recovered, found as expressed below:

NOTE: Not more than 2 corners, all in the same town and range, may be recorded on this certificate.

P.A. 345 1990 KENT COUNTY

PEER APPROVED 3/7/96

CHAIRMAN Randy J. Kolehouse

1	A	B	C	D	E	F	G	H	I	J	K	L	M
2		6	5		4		3		2		1		
3													
4		7	●	8		9		10		11		12	
5													
6		18		17		16		15		14		13	
7													
8		19		20		21		22		23		24	
9													
10		30		29		28		27		26		25	
11													
12		31		32		33		34		35		36	
13													

A. Description of original monument and accessories and/or subsequent restoration:

- | | | | | |
|-----|------|---------------|-----------|----------------------------|
| C-4 | 1837 | GLO | Whitcomb | Set Post |
| | 1937 | Kent Co. Wit. | | 3/4" Iron |
| | 1984 | LCRC #3750 | Kolehouse | Set Kent County Monument |
| | 1988 | LCRC #4678 | Brintnall | Reset Kent County Monument |
| | 1994 | LCRC #6901 | Byl | Reset Kent County Monument |

The position of this corner was previously approved by the Kent County Remonumentation Peer Group, monumented by Randy J. Kolehouse on 2/25/84 and was recorded per LCRC #3750

B. Description of corner evidence found and/or method applied in restoring or reestablishing corner:


C-4 Found standard Kent Co. Mon. (Harrison) per witnesses from above LCRC as set by William R. Byl at the same location as set in 1984 by Randy J. Kolehouse in place of the 1/2" Rebar and 3/4" Iron he found. Both checks with Kent Co. Wit. and previous data.
LCRC #3750

- | | |
|----------------------------------|----------------------------------|
| Nail/tag 14" Maple S75°W 32.75' | Nail/tag P. Pole N00°E 44.59' |
| Nail/tag P&T Pole North 44.58' | Nail/tag 16" Poplar S90°E 32.05' |
| Nail/tag 14" Poplar East 32.10' | Nail/tag 20" Poplar S45°E 27.51' |
| Nail/tag 14" Poplar S45°E 27.80' | Nail/tag 20" Maple S75°W 32.65' |
| C/L MH S45°W 25.8' | Nail/tag 24" Maple N45°W 69.80' |
| | C/L MH S00°E 9.59' |

The selected location is accepted by me and is generally accepted by professional surveyors as the best available evidence of the position of the original corner.

C. Description of monument for corner and accessories established to perpetuate locating the position of the corner:

- | | |
|---|-----------------------------|
| C-4 Standard Kent County Monument | |
| Nail & KC Remon. tag W. side P. Pole | N00°E 44.59' |
| Nail & KC Remon. tag N. side 16" Poplar | S90°E 32.05' |
| New Nail & KC Remon. tag SW side 20" Poplar | S45°E 27.51' |
| Centerline of top of fire hydrant | S00°E 9.59' |
| Nail & KC Remon. tag N. side 20" Maple | S75°W 32.65' |
| Nail & KC Remon. tag S. side 24" Maple | N45°W 69.80' |
| Centerline of manhole | S45°W 25.76' |
| C/L Asph. Rd. is West 18'+ | On fence & tree row to West |

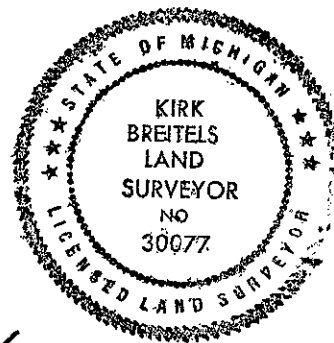

Signed by Kirk Breitels

Date 2/6/96

Surveyor's Michigan License No. 30077