

SURVEY & REMONUMENTATION

FEB 14 1997

KENT COUNTY REMONUMENTATION

COMMISSION

LAND CORNER RECORDATION CERTIFICATE
Filing Requirement of Act 74, Mich. P.A. 1970

For corners in

KENT COUNTY

(County)

Located In:

Corner Code #

1. Public Land Survey	T <u>8N</u>	R <u>11W</u>	<u>C-5</u>
	T	R	
	T	R	
	T	R	
2. Property Controlling in Section	S	T	R
	S	T	R
3. Miscellaneous Property in Sec.	S	T	R
	S	T	R

STATE OF MICHIGAN
COUNTY OF KENT
RECEIVED FOR RECORD

96 MAR 20 AM 8:52

REG. OF DEEDS

Lucy Ford

9035

Register of Deeds Stamp & File Number

4. Lot No. _____, Recorded Plat _____
5. Private Claims _____


I, Kirk Breitels, in a field survey on Jan. 19, 1996 do hereby state that under requirements of P.A. 74, Michigan P.A. of 1970, the corner points mentioned in lines 1 and 2 above were in conformance with regulations and rules therefore as required in the current manual of survey instructions of the United States Department of the Interior, Bureau of Land Management or by a decree of a Court of Law and /or that the corner points mentioned in lines 3, 4 and 5 above were in conformance with the rules of the Michigan Board of Land Surveyors or by a Decree of a Court of Law; established, re-established, monumented, recovered, found as expressed below:

NOTE: Not more than 2 corners, all in the same town and range, may be recorded on this certificate.

P.A. 345 1990 KENT COUNTY

PEER APPROVED 3/6/96

CHAIRMAN Harry Hubers

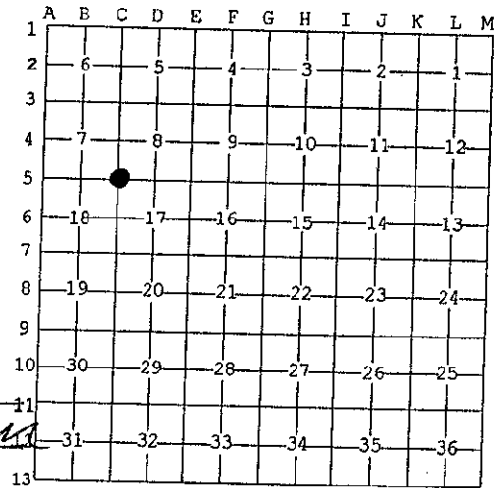

A. Description of original monument and accessories and/or subsequent restoration:

C-5	1837	GLO	Whitcomb	Set Post
	1950	Kent Co. Wit.		3/4" Iron
	1973	LCRC #585	Spicer	3/4" Iron
	1981	LCRC #2266	Bueche	Set Kent County Monument
	1994	LCRC #6902	Byl	Kent County Monument

The position of this corner was previously approved by the Kent County Remonumentation Peer Group, monumented by John C. Bueche on 10/24/81 and was recorded per LCRC #2266.

B. Description of corner evidence found and/or method applied in restoring or reestablishing corner:

C-5 Found standard Kent Co. Mon. (Harrison) per witnesses from above LCRC as set by John C. Bueche in place of the 3/4" x 18" Iron he found. Said Iron checks with LCRC #585. Kent Co. witnesses are gone
LCRC #2266 & #6902

Nail & KC Remon.	tag W. side	10" Oak	N20°E	23.87'
Nail & KC Remon.	tag E. side	9" Poplar	N20°W	24.15'
Nail & KC Remon.	tag S. side	8" Oak	S70°W	29.83'
Nail & KC Remon.	tag W. side	10" Oak	S20°W	29.76'
Nail & KC Remon.	tag S. side	10" Maple	N70°E	19.50'

The selected location is accepted by me and is generally accepted by professional surveyors as the best available evidence of the position of the original corner.

C. Description of monument for corner and accessories established to perpetuate locating the position of the corner:

C-5 Standard Kent County Monument

Nail & KC Remon.	tag W. side	10" Oak	N20°E	23.87'
Nail & KC Remon.	tag E. side	12" Poplar	N20°W	24.17'
Nail & KC Remon.	tag S. side	8" Oak	S70°W	29.92'
Nail & KC Remon.	tag W. side	12" Oak	S20°W	29.78'
Nail & KC Remon.	tag S. side	10" Maple	N70°E	19.50'



Signed by Kirk Breitels

Date 2/6/96

Surveyor's Michigan License No. 30077