

SURVEY & REMONUMENTATION

FEB 14 1997

COMMISSION

KENT COUNTY REMONUMENTATION

LAND CORNER RECORDATION CERTIFICATE
Filing Requirement of Act 74, Mich. P.A. 1970

STATE OF MICHIGAN
COUNTY OF KENT
RECEIVED FOR RECORD
96 MAR 20 AM 8:54

REG. OF DEEDS

Lucy Spauld

9039

Register of Deeds Stamp & File Number

For corners in

KENT COUNTY

(County)

Located In:

Corner Code #

1. Public Land Survey

T	8N	R	11W	C-9
T		R		
T		R		
T		R		
S		T		
S		T		
S		T		
S		T		

2. Property Controlling in Section

S		T		
S		T		
S		T		
S		T		

3. Miscellaneous Property in Sec.

4. Lot No. _____, Recorded Plat _____


5. Private Claims _____

I, Kirk Breitels, in a field survey on Jan. 18, 1996 do hereby state that under requirements of P.A. 74, Michigan P.A. of 1970, the corner points mentioned in lines 1 and 2 above were in conformance with regulations and rules therefore as required in the current manual of survey instructions of the United States Department of the Interior, Bureau of Land Management or by a decree of a Court of Law and /or that the corner points mentioned in lines 3, 4 and 5 above were in conformance with the rules of the Michigan Board of Land Surveyors or by a Decree of a Court of Law; established, re-established, monumented, recovered, found as expressed below:

NOTE: Not more than 2 corners, all in the same town and range, may be recorded on this certificate.

P.A. 345 1990 KENT COUNTY

PEER APPROVED 3/7/96
CHAIRMAN Harry Huber

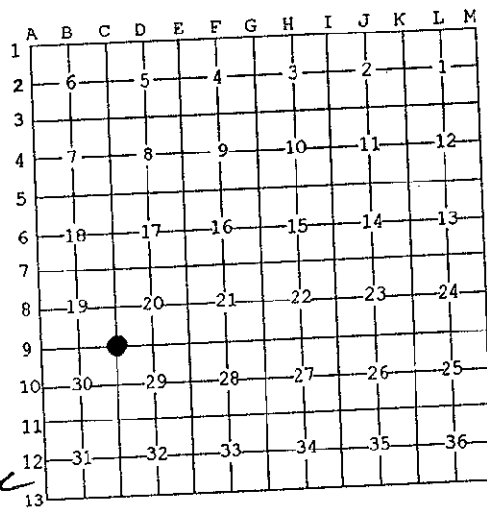

A. Description of original monument and accessories and/or subsequent restoration:

C-9	1837	GLO	Whitcomb	Set Post
	1930	Kent Co. Wit.		"X" on Stone
	1975	LCRC #877	Nederveld	"X" on Stone
	1982	LCRC #3278	Hay	Set Kent County Monument
	1983	LCRC #3515	Brintnall	Kent County Monument
	1994	LCRC #6906	Byl	Kent County Monument

The position of this corner was previously approved by the Kent County Remonumentation Peer Group, monumented by Clayton S. Hay on 5/12/82 and was recorded per LCRC #3278.

B. Description of corner evidence found and/or method applied in restoring or reestablishing corner:

C-9 Found standard Kent Co. Mon. (Harrison) per witnesses from above LCRC as set by Clayton S. Hay in place of the Stone with "X" on top he found. Said Stone checks with Kent Co. Wit. and LCRC #877.
LCRC #3278 & #6906

- Nail & KC Remon. tag N. side fence post N90°W 4.27' Nail & KC Remon. tag N. side
- Nail & KC Remon. tag E. side 12" Oak N02°W 8.88' Tri. 6"-12" Maple
- Nail & KC Remon. tag SE side 10" Cherry N15°E 15.31' S80°E 41.70'
- Nail & KC Remon. tag SE side 12" Cherry N75°E 33.64'
- Nail & KC Remon. tag N. side fence post N90°E 12.35'

The selected location is accepted by me and is generally accepted by professional surveyors as the best available evidence of the position of the original corner.

C. Description of monument for corner and accessories established to perpetuate locating the position of the corner:

C-9 Standard Kent County Monument

Nail & KC Remon. tag N. side fence post	N90°W	4.27'
Nail & KC Remon. tag E. side 24" Oak	N02°W	8.93'
Nail & KC Remon. tag SE side 12" Cherry	N15°E	15.37'
Nail & KC Remon. tag SE side 15" Cherry	N75°E	33.64'
Nail & KC Remon. tag N. side fence post	N90°E	12.35'
Nail & KC Remon. tag N. side Tri. 6"-12" Maple	S80°E	41.70'



Signed by

Kirk Breitels

Date

2/6/96

Surveyor's Michigan License No.

30077