

**SURVEY & REMONUMENTATION**

APR 28 1995

KENT COUNTY REMONUMENTATION

STATE OF MICHIGAN  
COUNTY OF KENT  
RECEIVED FOR RECORD

COMMISSION

LAND CORNER RECORDATION CERTIFICATE  
Filing Requirement of Act 74, Mich. P.A. 1970

94 DEC 27 AM 9:04

For corners in  
KENT COUNTY


(County)	Located In:	Corner Code #
1. Public Land Survey	T 8N R 11W	C-12
	T _____ R _____	_____
	T _____ R _____	_____
	T _____ R _____	_____
2. Property Controlling in Section	S _____ T _____ R _____	_____
	S _____ T _____ R _____	_____
3. Miscellaneous Property in Sec.	S _____ T _____ R _____	_____
	S _____ T _____ R _____	_____

*Lucy Bond*  
REG. OF DEEDS

7896

Register of Deeds Stamp & File Number

4. Lot No. \_\_\_\_\_, Recorded Plat \_\_\_\_\_  
5. Private Claims \_\_\_\_\_

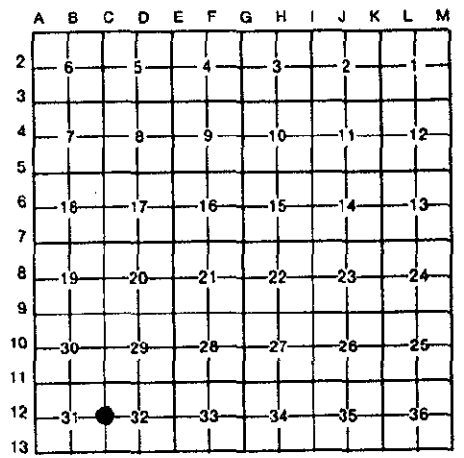

I, William R. Byl, in a field survey on Aug. 1, 19 94, do hereby certify that under requirements of P.A. 74, Michigan P.A. of 1970, the corner points mentioned in lines 1 and 2 above were in conformance with regulations and rules therefore as required in the current manual of survey instructions of the United States Department of the Interior, Bureau of Land Management or by a decree of a Court of Law and/or that the corner points mentioned in lines 3, 4 and 5 above were in conformance with the rules of the Michigan Board of Land Surveyors or by a Decree of a Court of Law; established, re-established, monumented, re-monumented, recovered, found as expressed below:

**NOTE: Not more than 4 corners, all in the same town and range, may be recorded on this certificate.**

A. Description of original monument and accessories and/or subsequent restoration:

C-12	1831	GLO	Mullett	Set Post
	1954	Kent Co. Wit.		Conc. Monument
	1978	LCRC #1150	Merdzinski	Conc. Monument
	1981	LCRC #2328	Bueche	Set Kent County Monument
	1990	LCRC #6908	Byl	Reset Kent County Monument

P.A. 345 1990 KENT COUNTY  
PEER APPROVED 12/22/94  
CHAIRMAN *Harry Huber*

The position of this corner was previously approved by the Kent County Remonumentation Peer Group, monumented by John C. Bueche on 11/6/81 and was recorded per LCRC #2328

B. Description of corner evidence found and/or method applied in restoring or reestablishing corner:

C-12 Found standard Kent Co. Mon. (Harrison) per witnesses from above LCRC as set by William R. Byl in the same location as set in 1981 by John C. Bueche in place of the Conc. Monument he found. Said Conc. Monument checks with Kent Co. Wit. and LCRC #1150.

LCRC #2328		LCRC #6908	
SE cor. hse. foundation	N80°W 80.72'	SE cor. hse. fdn.	N80°W 80.72'
NE cor. hse. foundation	N35°W 89.20'	SE cor. brk. fire place	N05°W 93.60'
SE cor. brick fire place	N05°W 93.60'	NW cor. brick house	S80°W 122.52'
NW cor. brick house	S80°W 122.52'	Nail & KC tag 30" Maple	S30°E 53.10'
		Nail & KC tag 36" Oak	N50°E 51.47'
		Nail & tag 40" Stump	S85°W 7.91'

The selected location is accepted by me and is generally accepted by professional surveyors as the best available evidence of the position of the original corner.

C. Description of monument for corner and accessories established to perpetuate locating the position of the corner:

C-12 Standard Kent County Monument			
SE cor. hse. foundation		N80°W	80.72'
SE cor. brick fire place		N05°W	93.60'
NW cor. brick house		S80°W	122.52'
Nail & KC Remon. tag SW side 30" Maple		S30°E	53.10'
Nail & KC Remon. tag NW side 36" Oak		N50°E	51.47'
Nail & KC Remon. tag S. side 40" Stump		S85°W	7.91'



Signed by *William R. Byl*  
Surveyor's Michigan License No. 23502

Date 12/07/94