

FEB 14 1997

COMMISSION

KENT COUNTY REMONUMENTATION

LAND CORNER RECORDATION CERTIFICATE  
Filing Requirement of Act 74, Mich. P.A. 1970

For corners in  
KENT COUNTY  
(County)

Located In:	Corner Code #
T8N R 11W	D-2
T R	
T R	
T R	
T R	
S T R	
S T R	
S T R	
S T R	

- 1. Public Land Survey
- 2. Property Controlling in Section
- 3. Miscellaneous Property in Sec.

STATE OF MICHIGAN  
COUNTY OF KENT  
RECEIVED FOR RECORD

96 SEP 13 PM 12:03

REG. OF DEEDS

9347

Register of Deeds Stamp & File Number

4. Lot No. \_\_\_\_\_, Recorded Plat \_\_\_\_\_  
5. Private Claims \_\_\_\_\_

I, Kirk Breitels, in a field survey on Aug. 23, 1996 do hereby state that under requirements of P.A. 74, Michigan P.A. of 1970, the corner points mentioned in lines 1 and 2 above were in conformance with regulations and rules therefore as required in the current manual of survey instructions of the United States Department of the Interior, Bureau of Land Management or by a decree of a Court of Law and /or that the corner points mentioned in lines 3, 4 and 5 above were in conformance with the rules of the Michigan Board of Land Surveyors or by a Decree of a Court of Law; established, re-established, monumented, recovered, found as expressed below:

	A	B	C	D	E	F	G	H	I	J	K	L	M
1													
2	6			5		4		3		2		1	
3													
4	7		8		9		10		11		12		
5													
6	16		17		16		15		14		13		
7													
8	19		20		21		22		23		24		
9													
10	30		29		28		27		26		25		
11													
12	31		32		33		34		35		36		
13													

NOTE: Not more than 2 corners, all in the same town and range, may be recorded on this certificate.

A. Description of original monument and accessories and/or subsequent restoration:

- D-2 1837--GL0--Not Set 1908--W & W--Fc. Cor. 1943-69--W & W--Set Iron per wit.  
-----Kent Co. Wit.---1 1/2" Iron  
N. leg tower W. 15.1' E. leg tower S. 16.7'
- 1972---LCRC #183---Spicer---1" Iron  
4" Elm N45°E 0.09' "L" Iron S10°W 16.7' "L" Iron S08°W? 15.1'
- 1978---LCRC #971---C. Hay---3/4" Iron at base of dead 5" Elm  
Angle Iron West 15.1' Angle Iron South 16.7'
- 1987---LCRC #4505---Wickham---3/4" Iron Pipe S. of 1 1/2" Iron Pipe  
N. leg tower W. 15.1' E. leg tower S. 16.7' 10" Elm S. 4.88'

B. Description of corner evidence found and/or method applied in restoring or reestablishing corner:


- D-2 Found 3/4" Iron Pipe from the following witnesses:  
"L" Iron W 14.84' Nail in dead 10" Elm S 4.88' PEER APPROVED 8/22/96  
"L" Iron S 16.73' 1 1/2" Iron Pipe N 6.36' CHAIRMAN *[Signature]*

Said 3/4" Iron Pipe is 11.3' N. and 5.8' E. from intersection of 1/4 lines and agrees with survey measurements of others.

The 3/4" Iron Pipe is accepted by me and is generally accepted by professional surveyors as the best available evidence of the position of the corner.

C. Description of monument for corner and accessories established to perpetuate locating the position of the corner:

- D-2 Set Standard Kent County Monument in place of 3/4" Iron Pipe.  
Set Nail & KC Remon. tag W. side dead 10" Elm S00°W 4.88'  
Set Nail & KC Remon. tag W. side 20" Poplar N15°W 11.18'  
"L" Iron (cut off at ground) S80°W 14.84'  
"L" Iron (cut off at ground) N15°W 16.73'  
1 1/2" Iron Pipe North 6.36'  
C/L Power Lines E-W are South 77'±  
C/L N-S trail is East 16'±

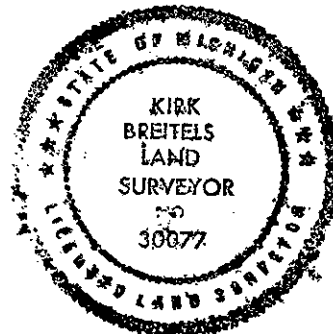

Signed by *Kirk Breitels*  
Surveyor's Michigan License No. 30077

Date 9/4/96