

FEB 14 1997

KENT COUNTY REMONUMENTATION

LAND CORNER RECORDATION CERTIFICATE  
Filing Requirement of Act 74, Mich. P.A. 1970

COMMISSION

For corners in  
KENT COUNTY  
(County)

Located In:	Corner Code #
T8N R11W	D-6
T___ R___	_____
T___ R___	_____
T___ R___	_____
S___ T___ R___	_____
S___ T___ R___	_____
S___ T___ R___	_____
S___ T___ R___	_____

- 1. Public Land Survey
- 2. Property Controlling in Section
- 3. Miscellaneous Property in Sec.

4. Lot No. \_\_\_\_\_, Recorded Plat \_\_\_\_\_  
 5. Private Claims \_\_\_\_\_


STATE OF MICHIGAN  
 COUNTY OF KENT  
 RECEIVED FOR RECORD  
 96 SEP 13 PM 12:05  
 REG. OF DEEDS  
*Lucy St. Paul*

9356

Register of Deeds Stamp & File Number

I, Kirk Breitels, in a field survey on Aug. 29, 1996 do hereby state that under requirements of P.A. 74, Michigan P.A. of 1970, the corner points mentioned in lines 1 and 2 above were in conformance with regulations and rules therefore as required in the current manual of survey instructions of the United States Department of the Interior, Bureau of Land Management or by a decree of a Court of Law and /or that the corner points mentioned in lines 3, 4 and 5 above were in conformance with the rules of the Michigan Board of Land Surveyors or by a Decree of a Court of Law, established, re-established, monumented, recovered, found as expressed below:

NOTE: Not more than 2 corners, all in the same town and range, may be recorded on this certificate.

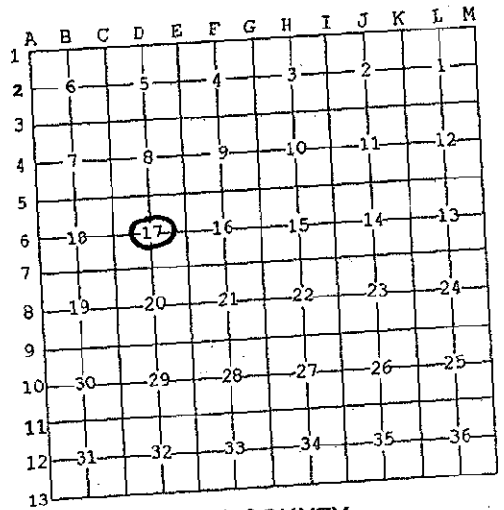

P.A. 345 1990 KENT COUNTY  
 PEER APPROVED 8/22/96  
 CHAIRMAN [Signature]

A. Description of original monument and accessories and/or subsequent restoration:

- D-6 1837---GLO---Not Set
- 1954-56---Williams & Works---Set and Used Iron at intersection 1/4 lines  
 14" Oak SSE 14.0' 30" Oak SW 40.5' 30" Oak NW 45.0'
- 1974---LCRC #693---Bonnama---1/2" Iron  
 24" Oak SE 12.17' 16" Oak SSE 21.68' I-Beam post W 68.95' & N 73.55'
- 1984---Survey---E. Glaza---C 1/4 cor. per LCRC #693
- 1994---Survey---Exxel Eng.---1" Iron  
 10" Oak S45°W 43.79' 30" Oak S20°E 12.91' 4" Tw. Maple N70°E 10.08'  
 Exxel Capped Iron West 13.63'


B. Description of corner evidence found and/or method applied in restoring or reestablishing corner:

D-6 Found 1 1/2" Iron Pipe per the following witnesses:  
 30" Oak SE 12.9' Spike in 4" Tw. Maple N70°E 10.11'  
 20" Oak SSE 21.5' Spike in 6" Tw. Maple S45°W 43.82' (10" Oak on survey)  
 Exxel Capped Iron West 13.64'  
 Said 1 1/2" Iron Pipe is 0.1' E. and 3.2' S. from intersection of 1/4 lines and agrees with survey measurements of others. C 1/4 corner per "English Meadows" (L. 100, Pg. 32) is per LCRC #693.

The 1 1/2" Iron Pipe is accepted by me and is generally accepted by professional surveyors as the best available evidence of the position of the corner.

C. Description of monument for corner and accessories established to perpetuate locating the position of the corner:

- D-6 Set Standard Kent County Monument in place of the 1 1/2" Iron Pipe
- Spike in W. side 30" Oak S30°E 12.91'
- Spike in N. side 6" Maple S60°E 2.26'
- Spike in N. side Tw. 4" Maple N70°E 10.11'
- Spike in NW side Tw. 6" Maple S50°W 43.82'
- Exxel Capped Iron West 13.64'

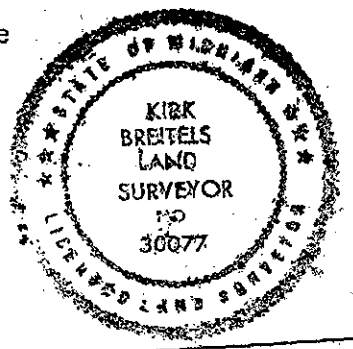

Signed by [Signature]  
 Surveyor's Michigan License No. 30077

Date 9/4/96