

KENT COUNTY REMONUMENTATION

MAY 28 1997

LAND CORNER RECORDATION CERTIFICATE  
Filing Requirement of Act 74, Mich. P.A. 1970

STATE OF MICHIGAN  
COUNTY OF KENT  
RECEIVED FOR RECORD  
96 MAR 20 AM 8:55  
COMMISSIONER  
REG. OF DEEDS  
*Lucy Staud*

For corners in  
KENT COUNTY  
(County)

Located In: Corner Code #

1. Public Land Survey	T	<u>8N</u>	R	<u>11W</u>	<u>D-8</u>
	T		R		
	T		R		
	T		R		
2. Property Controlling in Section	S		T	R	
	S		T	R	
3. Miscellaneous Property in Section	S		T	R	
	S		T	R	

9045

Register of Deeds Stamp & File Number

4. Lot No. \_\_\_\_\_, Recorded Plat \_\_\_\_\_  
5. Private Claims \_\_\_\_\_

I, Kirk Breitels, in a field survey on Jan. 16, 1996, do hereby certify that under requirements of P.A. 74, Michigan P.A. of 1970, the corner points mentioned in lines 1 and 2 above were in conformance with regulations and rules therefore as required in the current manual of survey instructions of the United States Department of the Interior, Bureau of Land Management or by a decree of a Court of Law and/or that the corner points mentioned in lines 3, 4 and 5 above were in conformance with the rules of the Michigan Board of Professional Surveyors or by a Decree of a Court of Law; established, re-established, monumented, re-monumented, recovered, found as expressed below:

A	B	C	D	E	F	G	H	I	J	K	L	M
2	6	5	4	3	2							
3												
4	7	8	9	10	11	12						
5												
6	18	17	16	15	14	13						
7												
8	19	20	21	22	23	24						
9												
10	30	29	28	27	26	25						
11												
12	31	32	33	34	35	36						
13												

NOTE: Not more than 4 corners, all in the same town and range, may be recorded on this certificate.

A. Description of original monument and accessories and/or subsequent restoration:

D-8	1837	GLO	Whitcomb	Not Set
	1974	LCRC #767	Spicer	1/2" Iron
	1992	LCRC #6644	Marschall	Established C 1/4 Sec. 20 from monuments of "Skyway Plat"

The position of this corner was previously approved by the Kent County Remonumentation Peer Group, monumented (witness monuemt) by Chris Marschall on 11/23/92 and was recorded per LCRC #6644.

B. Description of corner evidence found and/or method applied in restoring or reestablishing corner:

D-8 Did not find anything at this corner. Corner falls in or very near the rear of House #5591 Buthview Drive.


Refer to LCRC # 9046 for information of Witness Monument

C. Description of monument for corner and accessories established to perpetuate locating the position of the corner:

D-8 No Monument at this corner.

Refer to LCRC # 9046 for witnesses of Witness Monument

P.A. 345 1990 KENT COUNTY  
PEER APPROVED 3/7/96  
CHAIRMAN *Stan Huber*

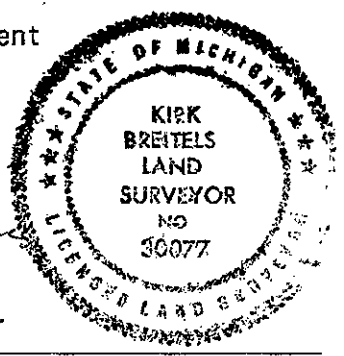

Signed by *Kirk Breitels*  
Surveyor's Michigan License No. 30077

Date 2/6/96