

SURVEY & REMONUMENTATION

FEB 14 1997

KENT COUNTY REMONUMENTATION

COMMISSION

LAND CORNER RECORDATION CERTIFICATE
Filing Requirement of Act 74, Mich. P.A. 1970

For corners in
KENT COUNTY

Located In: Corner Code #

1. Public Land Survey	T 8N R 11W	E-5
	T R	
	T R	
	T R	
2. Property Controlling in Section	S T R	
	S T R	
3. Miscellaneous Property in Sec.	S T R	
	S T R	

REG. OF DEEDS

Lucy Bond

95 JUN -7 AM 8:29

STATE OF MICHIGAN
COUNTY OF KENT
RECEIVED FOR RECORD

9184

Register of Deeds Stamp & File Number

4. Lot No. _____, Recorded Plat _____
5. Private Claims _____

I, Kirk Breitels, in a field survey on Apr. 1, 19 96 do hereby state that under requirements of P.A. 74, Michigan P.A. of 1970, the corner points mentioned in lines 1 and 2 above were in conformance with regulations and rules therefore as required in the current manual of survey instructions of the United States Department of the Interior, Bureau of Land Management or by a decree of a Court of Law and/or that the corner points mentioned in lines 3, 4 and 5 above were in conformance with the rules of the Michigan Board of Land Surveyors or by a Decree of a Court of Law; established, re-established, monumented, recovered, found as expressed below:

A	B	C	D	E	F	G	H	I	J	K	L	M
1												
2	6	5		4			3		2			1
3												
4	7	8		9			10		11			12
5												
6	18	17		16			15		14			13
7												
8	19	20		21			22		23			24
9												
10	30	29		28			27		26			25
11												
12	31	32		33			34		35			36
13												

NOTE: Not more than 2 corners, all in the same town and range, may be recorded on this certificate.

A. Description of original monument and accessories and/or subsequent restoration:

E-5	1837	GLO	Whitcomb	Set Post
	1964	Kent Co. Wit.		1/2" Iron
	1973	LCRC #611	VanKooten	No. desc. of corner
	1981	LCRC #2271	Bueche	Set Kent County Monument
	1993	LCRC #6918	Byl	Kent County Monument

P.A. 345 1990 KENT COUNTY

PEER APPROVED 5/30/96
CHAIRMAN [Signature]

The position of this corner was previously approved by the Kent County Remonumentation Peer Group, monumented by John C. Bueche on 10/16/81 and was recorded per LCRC #2271

B. Description of corner evidence found and/or method applied in restoring or reestablishing corner:

E-5 Found PK Nail at same location per wit. from above LCRC as set by John C. Bueche in place of the 1/2" Iron over a 1 1/2" Iron he found. Both Irons check with Kent Co. Wit. and LCRC #611. Set Standard Kent Co. Mon. (Harrison) in place of the PK Nail.
LCRC #2271

Nail/tag 8" Oak	N85°E	28.58'	Nail/tag 10" Oak	N85°E	28.58'
Nail/tag 8" Elm	S20°E	92.12'	Nail/tag 24" Twin Oak	N60°W	18.74'
Nail/tag 36" Oak	S10°W	70.93'	Nail/tag 8" Oak	S30°E	68.42'
Nail/tag 20" Twin Oak	N60°W	18.53'	Nail/tag 24" Oak	N20°W	70.03'
			Nail/tag 12" Pine	S75°W	47.82'


The selected location is accepted by me and is generally accepted by professional surveyors as the best available evidence of the position of the original corner.

C. Description of monument for corner and accessories established to perpetuate locating the position of the corner:

E-5 Standard Kent County Monument

Nail & KC Remon. tag NE side 8" Oak	S30°E	68.42'
Nail & KC Remon. tag NE side 24" Oak	N20°W	70.03'
Nail & KC Remon. tag N. side 12" Pine	S75°W	47.82'
Set Nail & KC Remon. tag N. side 20" Oak	N80°E	34.80'
Set Nail & KC Remon. tag N. side 40" Maple	N60°W	96.70'

W. edge blacktop is W. 11'±
C/L Post Dr. is N. 175'±

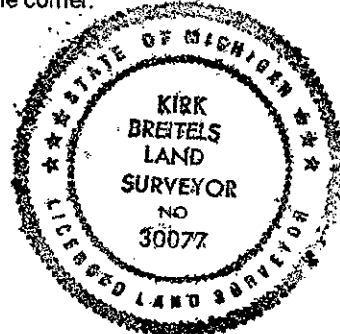

Signed by [Signature]
Surveyor's Michigan License No. 30077

Date 4/26/96