

Survey & REMONUMENTATION

FEB 14 1997

COMMISSION

KENT COUNTY REMONUMENTATION

LAND CORNER RECORDATION CERTIFICATE
Filing Requirement of Act 74, Mich. P.A. 1970

For corners in
KENT COUNTY
(County)

Located In:	Corner Code #
1. Public Land Survey	T8N R11W E-9
	T R
	T R
	T R
	T R
2. Property Controlling in Section	S T R
	S T R
3. Miscellaneous Property in Sec.	S T R
	S T R

4. Lot No. _____, Recorded Plat _____

5. Private Claims _____

STATE OF MICHIGAN
COUNTY OF KENT
RECEIVED FOR RECORD


96 JUN -7 AM 8:29

REG. OF DEEDS

[Signature]

9187

Register of Deeds Stamp & File Number

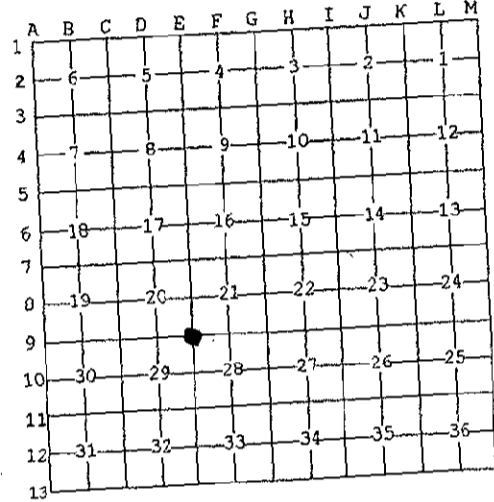

I, Kirk Breitels, in a field survey on Apr. 1, 1996 do hereby state that under requirements of P.A. 74, Michigan P.A. of 1970, the corner points mentioned in lines 1 and 2 above were in conformance with regulations and rules therefore as required in the current manual of survey instructions of the United States Department of the Interior, Bureau of Land Management or by a decree of a Court of Law and for that the corner points mentioned in lines 3, 4 and 5 above were in conformance with the rules of the Michigan Board of Land Surveyors or by a Decree of a Court of Law; established, re-established, monumented, recovered, found as expressed below:

NOTE: Not more than 2 corners, all in the same town and range, may be recorded on this certificate.


- A. Description of original monument and accessories and/or subsequent restoration:
- | | | | | |
|-----|------|---------------|----------|--------------------------|
| E-9 | 1837 | GLO | Whitcomb | Set Post |
| | 1941 | Kent Co. Wit. | | 3/4" Iron Pipe |
| | 1977 | LCRC #1060 | Bonnema | 3/4" Iron Pipe |
| | 1981 | LCRC #2333 | Bueche | Set Kent County Monument |
| | 1994 | LCRC #6922 | Byl | Kent County Monument |
- P.A. 345 1990 KENT COUNTY
PEER APPROVED 5/30/96
CHAIRMAN *[Signature]*

The position of this corner was previously approved by the Kent County Remonumentation Peer Group, monumented by John C. Bueche on 11/9/81 and was recorded per LCRC #2333

- B. Description of corner evidence found and/or method applied in restoring or reestablishing corner:
- E-9 Found standard Kent Co. Mon. (Harrison) per witnesses from above LCRC as set by John C. Bueche in place of the 1" x 12" Iron he found. Said Iron checks with Kent Co. Wit. and LCRC #1060.

- | | |
|---------------------------------------|---------------------------------------|
| <u>LCRC #2333 (Nail/tag in trees)</u> | <u>LCRC #6922 (Nail/tag in trees)</u> |
| 5-10" Maples N85°W 54.22' | 5-12" Maples N85°W 54.22' |
| 5-8" Maples N60°W 66.23' | 5-10" Maples N60°W 66.23' |
| 16" Poplar N85°E 36.43' | 18" Poplar N85°E 36.47' |
| 24" Poplar S40°E 39.88' | 27" Poplar S40°E 39.88' |
| 10" Ash N30°E 33.30' | 16" Ash N30°E 33.32' |
| 8" Ash S10°W 30.90' | 10" Ash S10°W 30.81' |
- The selected location is accepted by me and is generally accepted by professional surveyors as the best available evidence of the position of the original corner.

- C. Description of monument for corner and accessories established to perpetuate locating the position of the corner.
- | | | |
|---|-------|--------|
| E-9 Standard Kent County Monument | N85°W | 54.22' |
| Nail & KC Remon. tag S. side 5-12" Maples | N30°W | 66.23' |
| Nail & KC Remon. tag SW side 5-10" Maples | N30°E | 33.32' |
| Nail & KC Remon. tag NW side 16" Ash | N85°E | 36.47' |
| Nail & KC Remon. tag S. side 18" Poplar | N85°E | 39.88' |
| Nail & KC Remon. tag NE side 27" Poplar | S10°W | 30.81' |
| Nail & KC Remon. tag W. side 10" Ash | | |
| S. line of woods is S. 100'± | | |
| C/L foot path is E. 6'± | | |

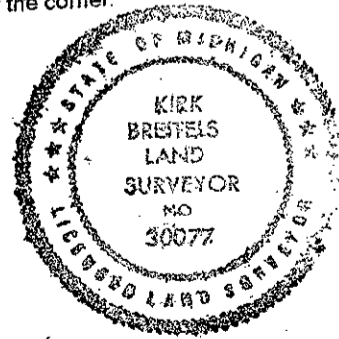

Signed by *[Signature]*
Surveyor's Michigan License No. 30077

Date 4/26/96