

SURVEY & REMONUMENTATION

FEB 14 1997

KENT COUNTY REMONUMENTATION

COMMISSION

LAND CORNER RECORDATION CERTIFICATE
Filing Requirement of Act 74, Mich. P.A. 1970

For corners in

KENT COUNTY

(County)

Located In:

Corner Code #

- | | | |
|------------------------------------|--------------------------|-------------|
| 1. Public Land Survey | T <u>8N</u> R <u>11W</u> | <u>E-11</u> |
| | T ___ R ___ | _____ |
| | T ___ R ___ | _____ |
| | T ___ R ___ | _____ |
| 2. Property Controlling in Section | S ___ T ___ R ___ | _____ |
| | S ___ T ___ R ___ | _____ |
| 3. Miscellaneous Property in Sec. | S ___ T ___ R ___ | _____ |
| | S ___ T ___ R ___ | _____ |

STATE OF MICHIGAN
COUNTY OF KENT
RECEIVED FOR RECORD

96 MAR 20 AM 8:56


REG. OF DEEDS

Lucy Stoddard

9056

Register of Deeds Stamp & File Number

4. Lot No. _____, Recorded Plat _____
5. Private Claims _____

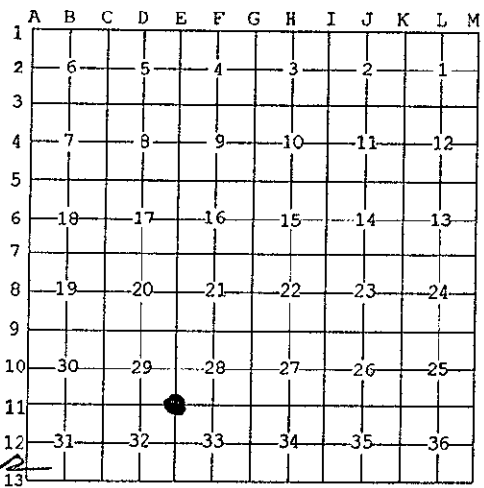

I, Kirk Breitels, in a field survey on Jan. 17, 1996 do hereby state that under requirements of P.A. 74, Michigan P.A. of 1970, the corner points mentioned in lines 1 and 2 above were in conformance with regulations and rules therefore as required in the current manual of survey instructions of the United States Department of the Interior, Bureau of Land Management or by a decree of a Court of Law and /or that the corner points mentioned in lines 3, 4 and 5 above were in conformance with the rules of the Michigan Board of Land Surveyors or by a Decree of a Court of Law; established, re-established, monumented, recovered, found as expressed below:

NOTE: Not more than 2 corners, all in the same town and range, may be recorded on this certificate.

P.A. 345 1990 KENT COUNTY
PEER APPROVED 2/7/96
CHAIRMAN Randy J. Kolehouse

A. Description of original monument and accessories and/or subsequent restoration:

E-11	1831	GLO	Mullett	Set Post
	1903-29	Williams & Works		Fence Corner
	1960	Williams & Works		Concrete Monument
	1984	LCRC #3792	Kolehouse	Set Kent County Monument
	1994	LCRC #6924	Byl	Kent County Monument

The position of this corner was previously approved by the Kent County Remonumentation Peer Group, monumented by Randy J. Kolehouse on 3/30/94 and was recorded per LCRC #3792.

B. Description of corner evidence found and/or method applied in restoring or reestablishing corner:

E-11 Found standard Kent Co. Mon. (Harrison) per witnesses from above LCRC as set by Randy J. Kolehouse in place of the Concrete Monument he found. Said Concrete Monument checks with Williams & Works witnesses of 1960 and "National Park" (plat) information.
LCRC #3792 & 6924

- Nail & KC Remon. tag NE side 12" Pine S35°E 33.60'
- Nail & KC Remon. tag NE side 10" Pine S65°E 29.55'
- Nail & KC Remon. tag NE side 16" Oak N45°W 6.68'
- Nail & KC Remon. tag E. side 24" Oak N10°E 8.62'

The selected location is accepted by me and is generally accepted by professional surveyors as the best available evidence of the position of the original corner.

C. Description of monument for corner and accessories established to perpetuate locating the position of the corner:

- E-11 Standard Kent County Monument
- Nail & KC Remon. tag NE side 14" Pine S35°E 33.54'
 - Nail & KC Remon. tag NE side 12" Pine S65°E 29.62'
 - Nail & KC Remon. tag NE side 18" Oak N45°W 6.70'
 - Nail & KC Remon. tag E. side 27" Oak N10°E 8.70'



Signed by *Kirk Breitels*
Surveyor's Michigan License No. 30077

Date 2/6/96