

SURVEY & REMONUMENTATION

FEB 14 1997

COMMISSION

KENT COUNTY REMONUMENTATION

LAND CORNER RECORDATION CERTIFICATE
Filing Requirement of Act 74, Mich. P.A. 1970

For corners in
KENT COUNTY

(County)

Located In:

Corner Code #

1. Public Land Survey	T8N	R11W	F-4
	T	R	
	T	R	
	T	R	
2. Property Controlling in Section	S	T	R
	S	T	R
3. Miscellaneous Property in Sec.	S	T	R
	S	T	R

REG. OF DEEDS

Lucy Stand

96 SEP 13 PM 12:05

STATE OF MICHIGAN
COUNTY OF KENT
RECEIVED FOR RECORD

9353

Register of Deeds Stamp & File Number

4. Lot No. _____, Recorded Plat _____
5. Private Claims _____

I, Kirk Breiteis, in a field survey on Aug. 23, 1996, do hereby state that under requirements of P.A. 74, Michigan P.A. of 1970, the corner points mentioned in lines 1 and 2 above were in conformance with regulations and rules therefore as required in the current manual of survey instructions of the United States Department of the Interior, Bureau of Land Management or by a decree of a Court of Law and for that the corner points mentioned in lines 3, 4 and 5 above were in conformance with the rules of the Michigan Board of Land Surveyors or by a Decree of a Court of Law; established, re-established, monumented, recovered, found as expressed below:

NOTE: Not more than 2 corners, all in the same town and range, may be recorded on this certificate.

1	A	B	C	D	E	F	G	H	I	J	K	L	M
2		6	5		4		3		2		1		
3													
4		7		8		9		10		11		12	
5													
6		18		17		16		15		14		13	
7													
8		19		20		21		22		23		24	
9													
10		30		29		28		27		26		25	
11													
12		31		32		33		34		35		36	
13													

A. Description of original monument and accessories and/or subsequent restoration:

- F-4 1837---GLO---Not Set
- 1947-54---Williams & Works---Accepted fence corner and set Iron 20" Oak NW 7.5' T. Pole E 21.93' 12" Oak SE 42.8' 12" Oak SSW 60.5'
- 1955---Kent Co. Wit.---Iron (Same wit. as Williams & Works ±)
- 1975---LCRC #819---Bonnema---1/2" Iron Pipe 26" Oak NNW 7.84' 22" Oak SSW 60.71' T. Pole E 22.36'
- 1978---Survey---Nederveld & Jonker---Rd. Iron (Wit. same as LCRC #819 ±)
- 1992---Survey---W. Glaza---Per LCRC #819

B. Description of corner evidence found and/or method applied in restoring or reestablishing corner:

- F-4 Found 1/2" Iron Pipe from the following witnesses:
Stump N 8' 24" Oak SE 43.4'
30" Oak SSW 60.8'

P.A. 345 1990 KENT COUNTY
PEER APPROVED 8/22/96


CHAIRMAN *[Signature]*

Said 1/2" Iron Pipe is 9.6' N. and 3.6' E. from intersection of 1/4 lines and agrees with survey measurements of Exxel Eng., Nederveld & Jonker, Glaza, Bvl.

The 1/2" Iron Pipe is accepted by me and is generally accepted by professional surveyors as the best available evidence of the position of the corner.

C. Description of monument for corner and accessories established to perpetuate locating the position of the corner:

- F-4 Set Standard Kent County Monument in place of 1/2" Iron Pipe
- Set Nail & KC Remon. tag W. side 20" Oak N00°E 10.99'
- Set Nail & KC Remon. tag N. side 16" Oak S65°E 34.67'
- Set Nail & KC Remon. tag W. side 30" Oak S20°W 60.79'
- Set Nail & KC Remon. tag W. side 12" Hickory S60°W 30.46'
- Set Nail & KC Remon. tag NE side 24" Oak S35°E 43.42'

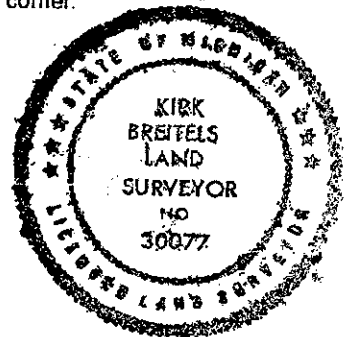

Signed by *Kirk Breiteis*
Surveyor's Michigan License No. 30077

Date 9/4/96